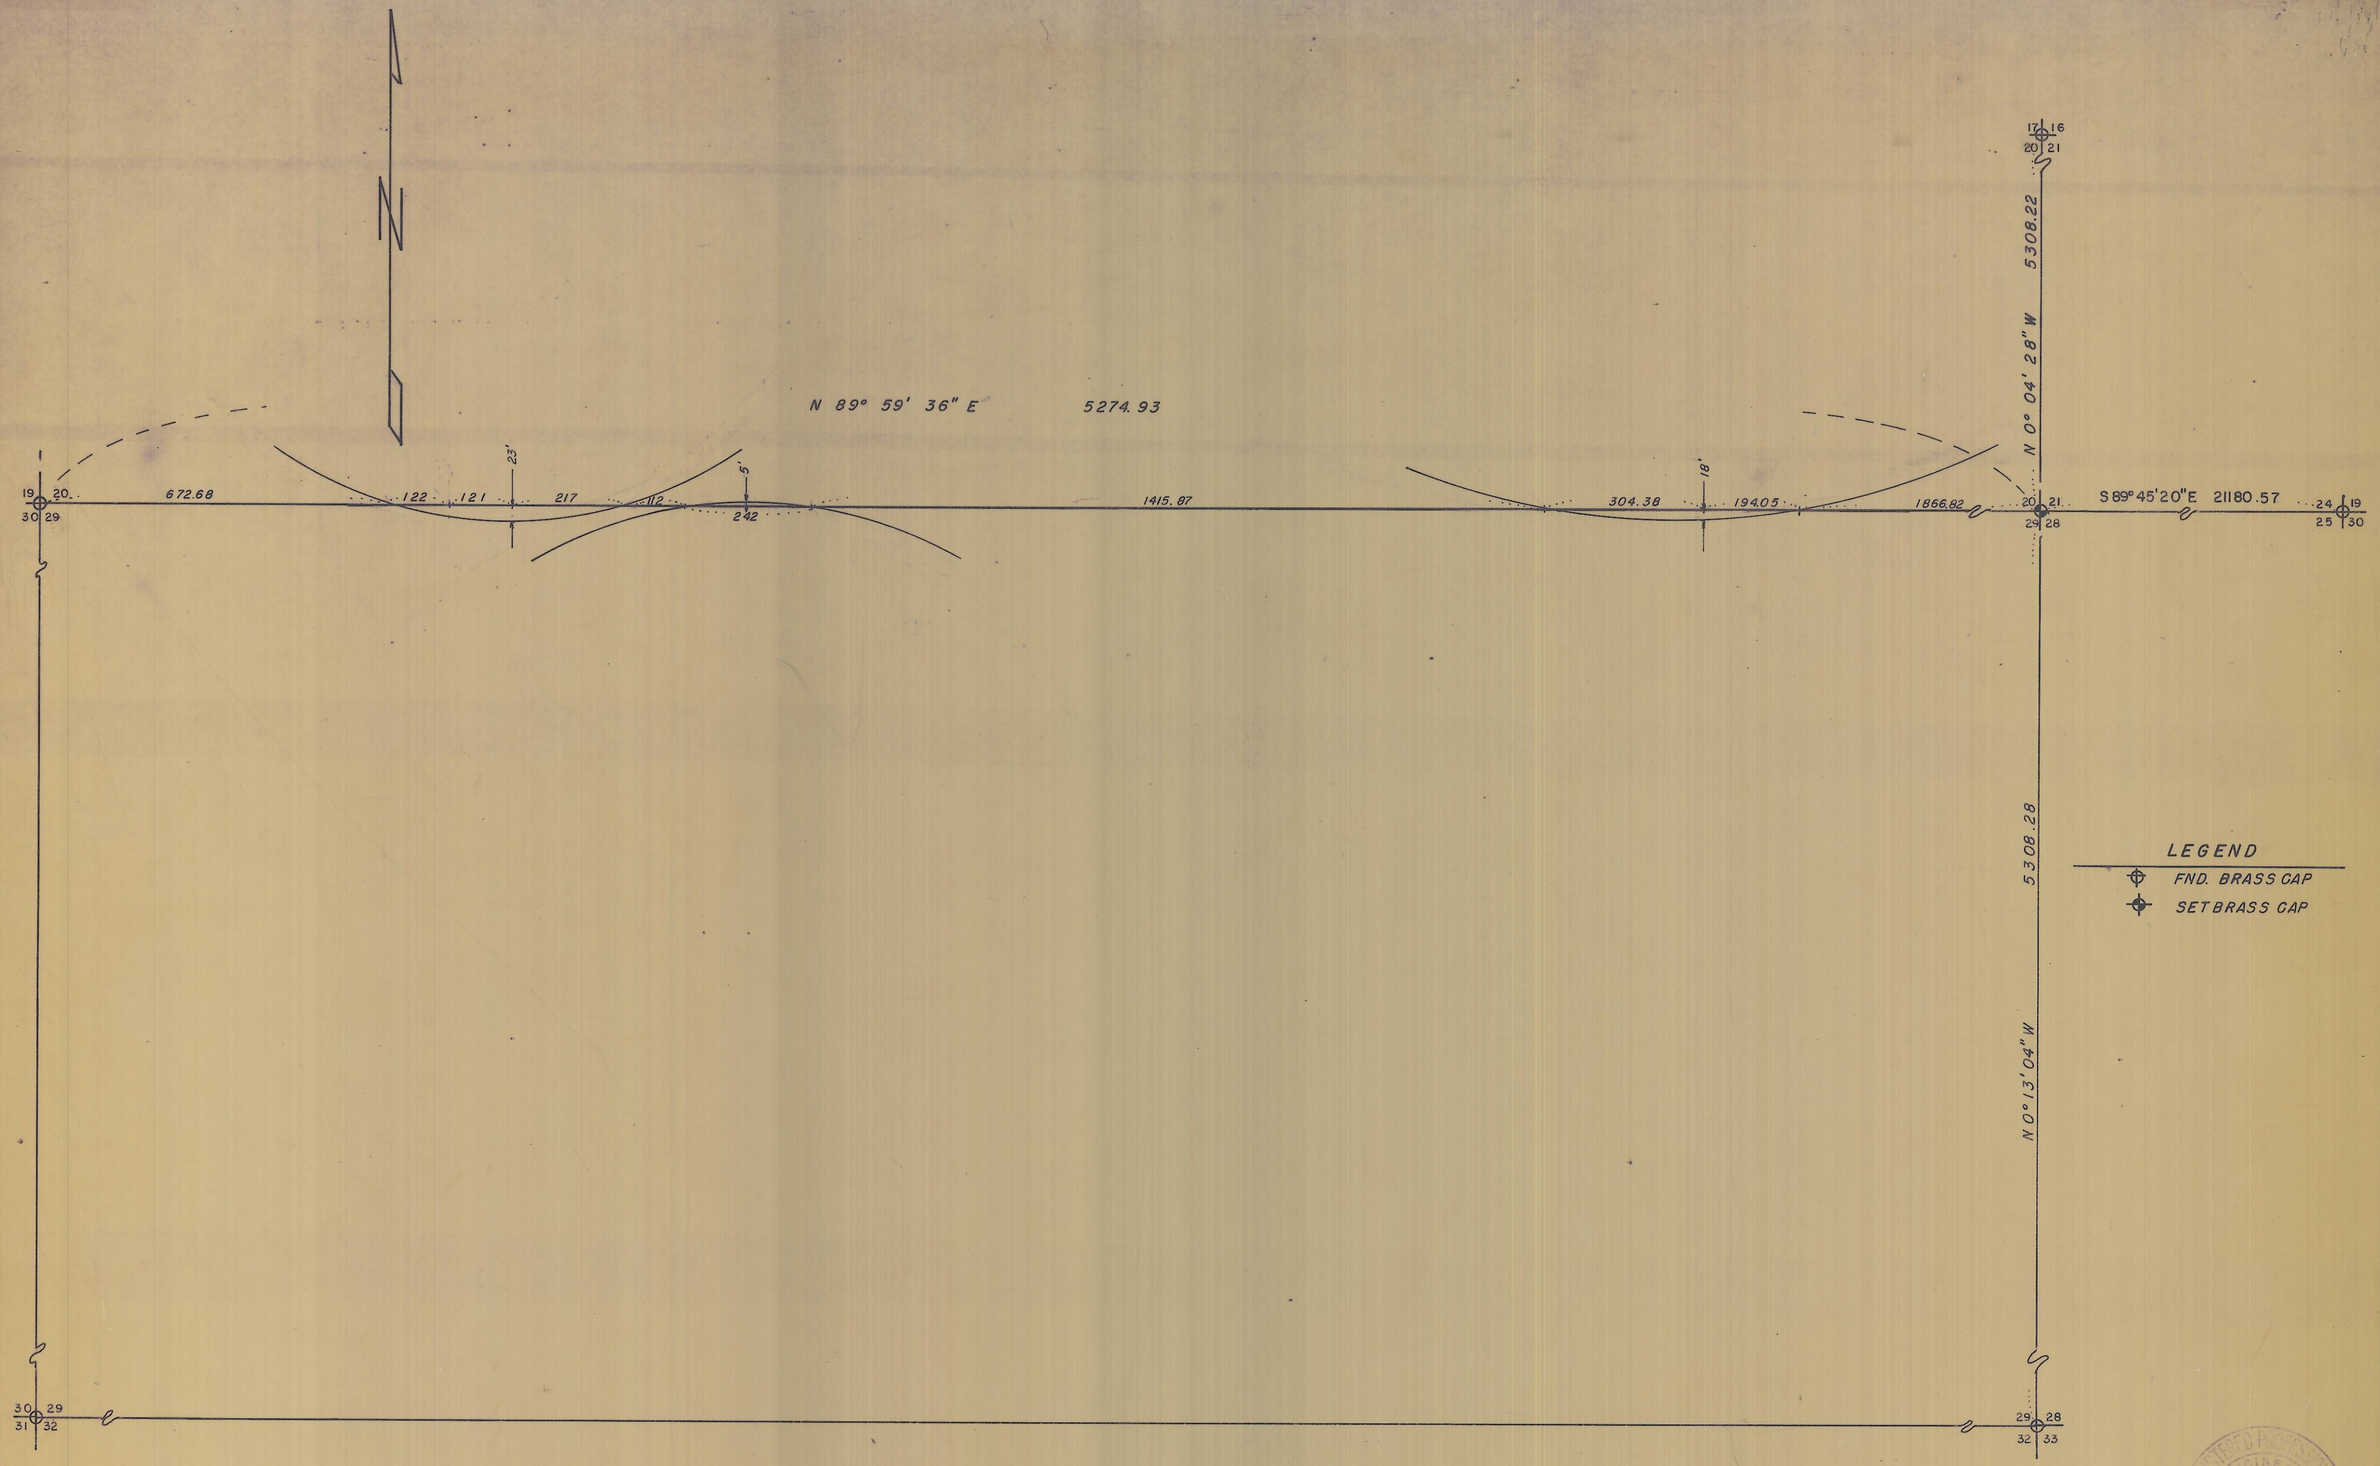

REGISTERED PROFESSIONAL ENGINEER 7728 David W. Krumlee OREGON JULY 13, 1973 DAVID H. KRUMLEE

SURVEY FOR MEL GOODIN SEC. 29, T.5N., R.30E.W.M.	WAYNE HARRIS CO. INC. I-168-B ENGINEERS – SURVEYORS PENDLETON, OREGON				
	SCALE	1" = 200'	DRN. BY	RS	DRNG. NO.
	DATE	12-12-74	CKD. BY		74-437 C