


DESCRIPTION: LOTS 2,3,4, and 5 OF BLOCK 7 AS SHOWN ON THE FIRST AMENDED AND SUPPLEMENTAL PLAT OF CHARLES TRACTS, LOCATED IN SEC 27, T5N., R28E., WM., UMATILLA COUNTY, OREGON.

CERTIFICATION

I, G DENNIS EDWARDS A REGISTERED PROFESSIONAL LAND SURVEYOR HEREBY CERTIFY THAT ON 9/25/75 A SURVEY WAS STARTED AND COMPLETED ON 9/30/75 OF THE LANDS SHOWN HEREON BY ME OR UNDER MY DIRECTION THAT THE PROPERTY CORNERS ARE MARKED AS SHOWN, AND THAT THIS MAP IS A TRUE AND ACCURATE REPRESENTATION OF SAID SURVEY.

REGISTERED PROFESSIONAL LAND SURVEYOR
G. Dennis Edwards
 OREGON
 JULY 15, 1971
 G. DENNIS EDWARDS
 951

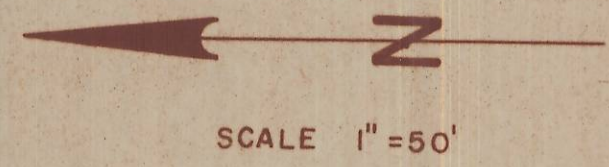

LEGEND

- PROPERTY LINE
- EASEMENT LINE
- N-S 1/4 LINE
- SET I.R.
- FND. I.R.
- (000) OF REC.

SURVEY FOR **KNAPP MOBIL HOME DISCOUNT**

GASCHLER & ASSOCIATES
 ONTARIO, OREGON HERMISTON, OREGON

DESIGNED BY: *[Signature]* DRAWN BY: *[Signature]* APPROVED BY: *GDE.*

DATE: 10/1/75 DRAWING NO. B-II BK. PG.

SHEET 1 OF 1 JOB NO. HSO-1475 REVISED: