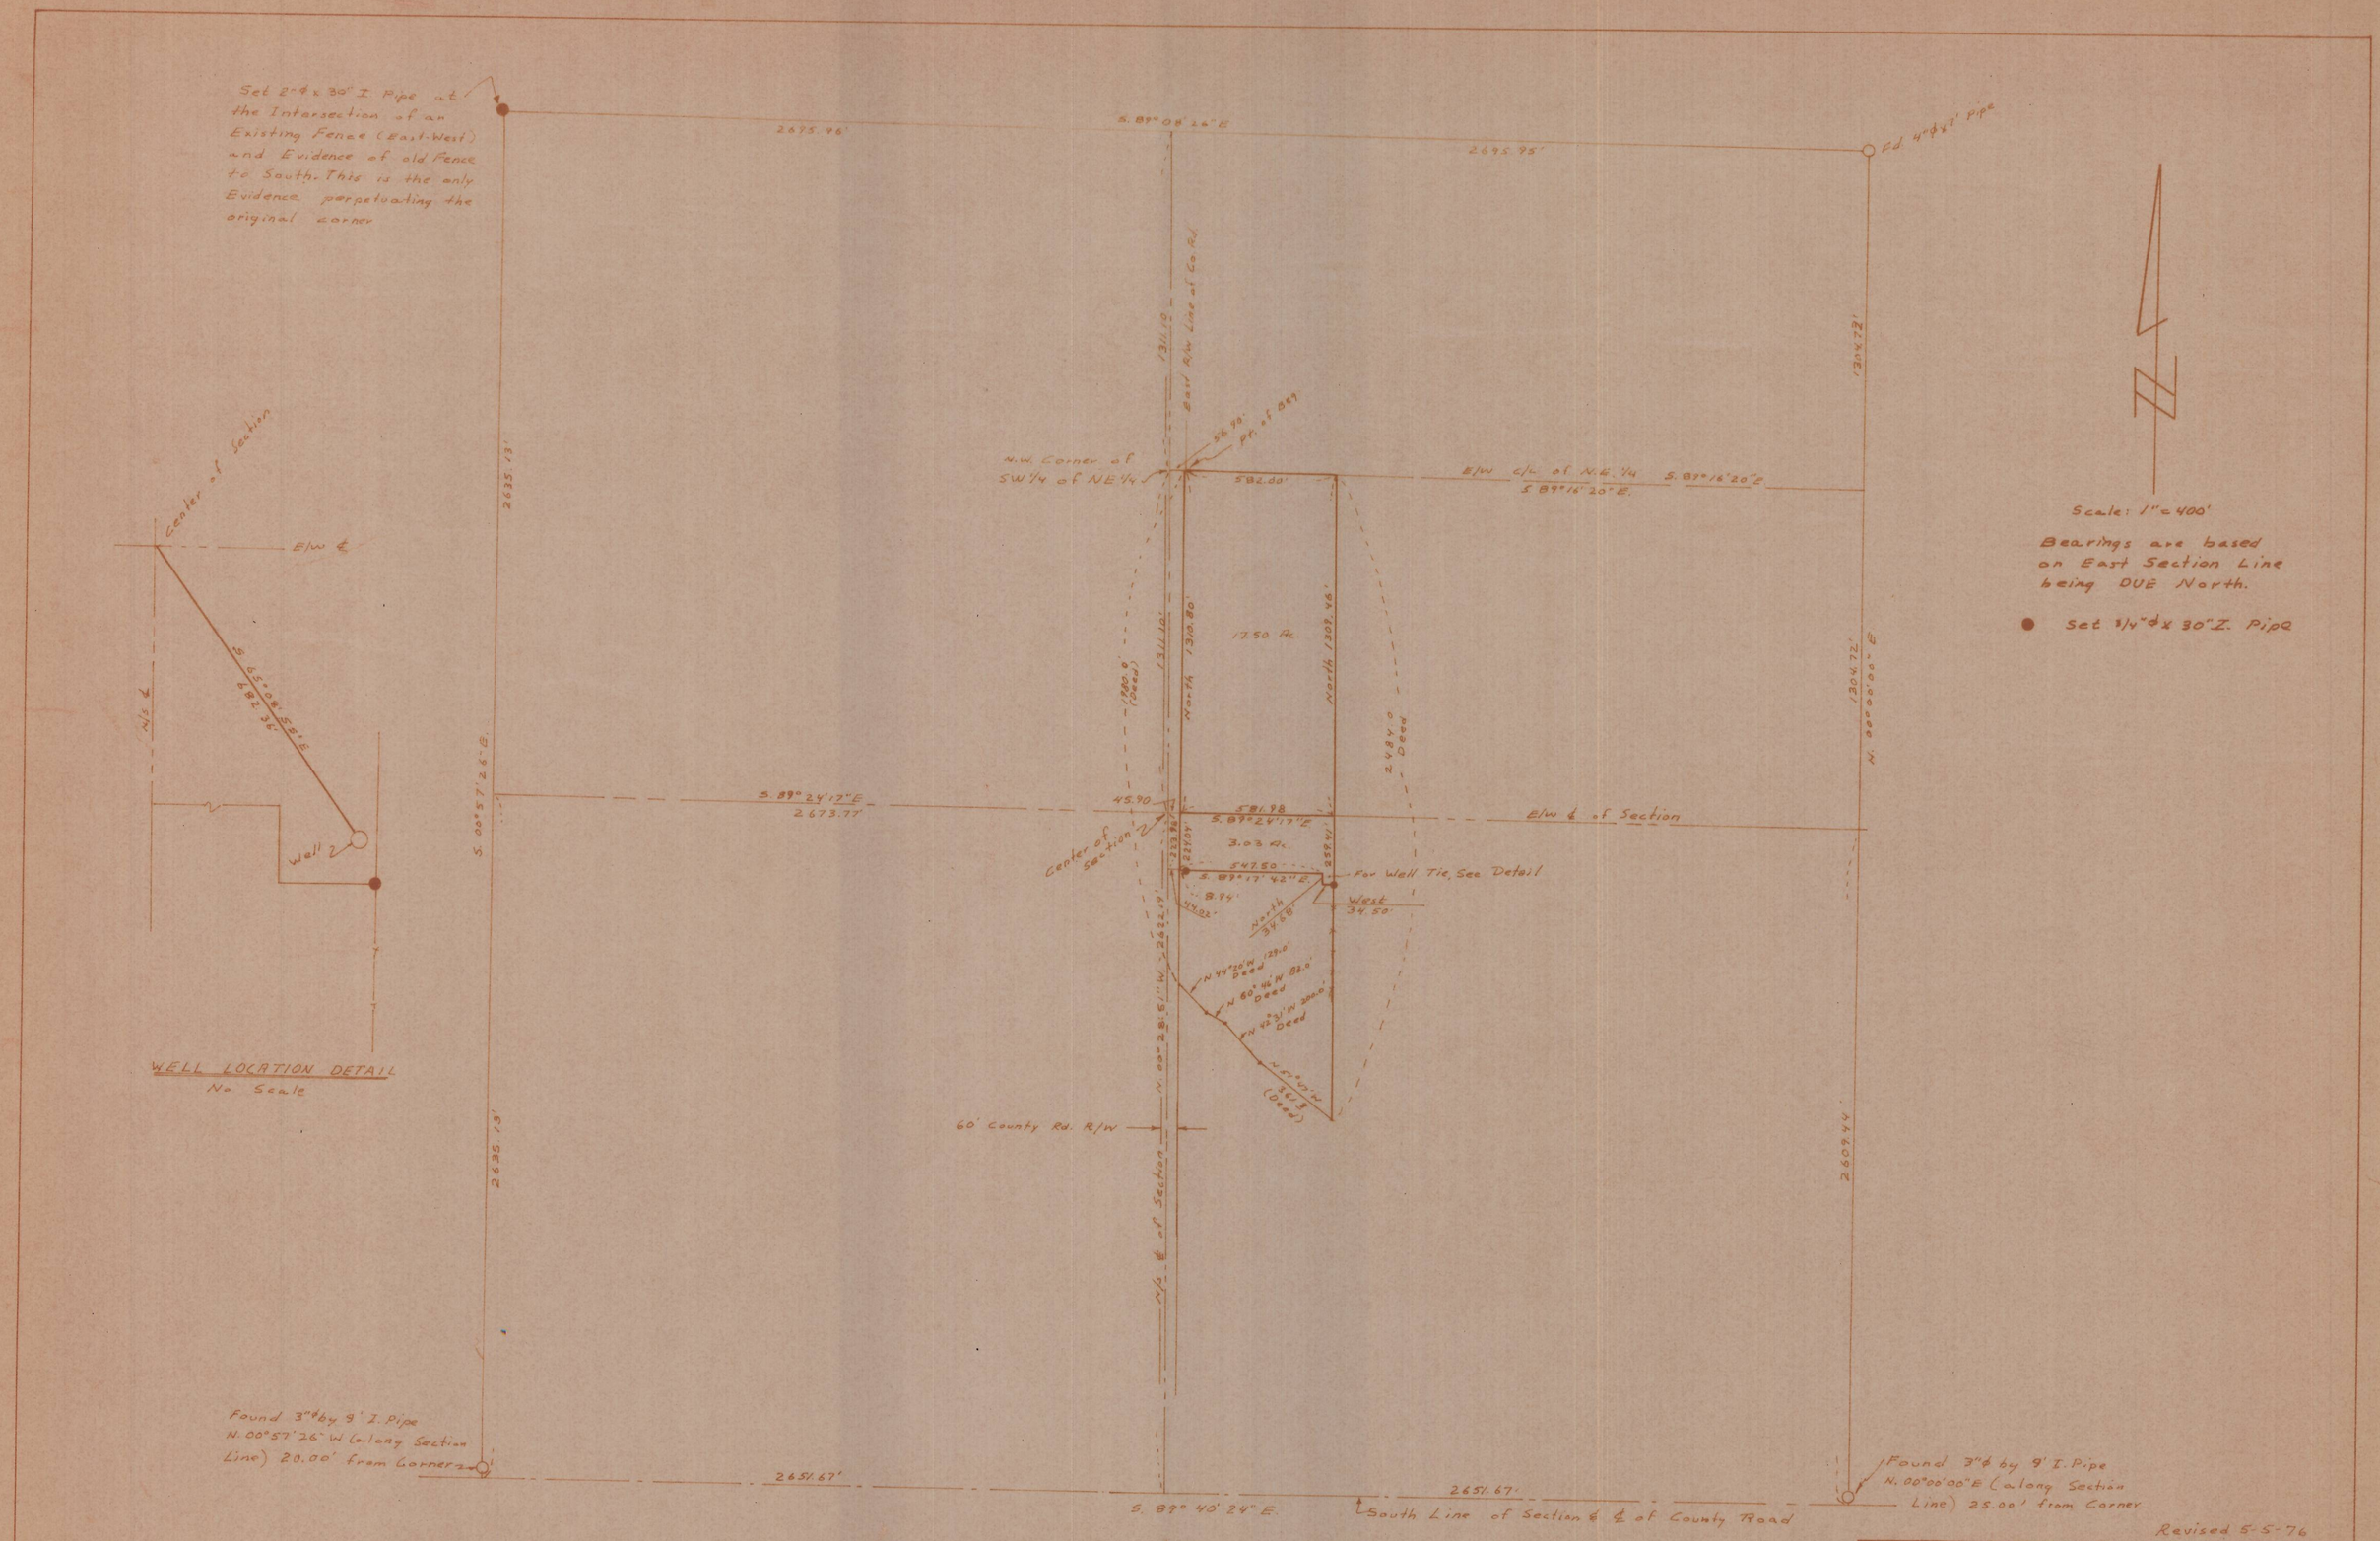

Revised 5-5-76

REGISTERED PROFESSIONAL ENGINEER 5408 OREGON JULY 9, 1968 DONALD L. STAEBLER

Donald L. Staebler

SURVEY FOR
DON K. SMITH
IN THE
EAST HALF OF SECTION 20,
T. 6 N. R. 36 E.W.M.

Date: 12-27-74	Dwn. By: HFS	Scale: 1" = 400'

DONALD L. STAEBLER
CONSULTING ENGINEER
P.O. BOX 91
PENDLETON OREGON 97801

K-79-B