

BOLCONS STREET

MORROW STREET

FND. B.C.

FND. B.C.

820.20 R
820.00 M


MAIN STREET

30.00

30.00

BLOCK 2

BLOCK 1

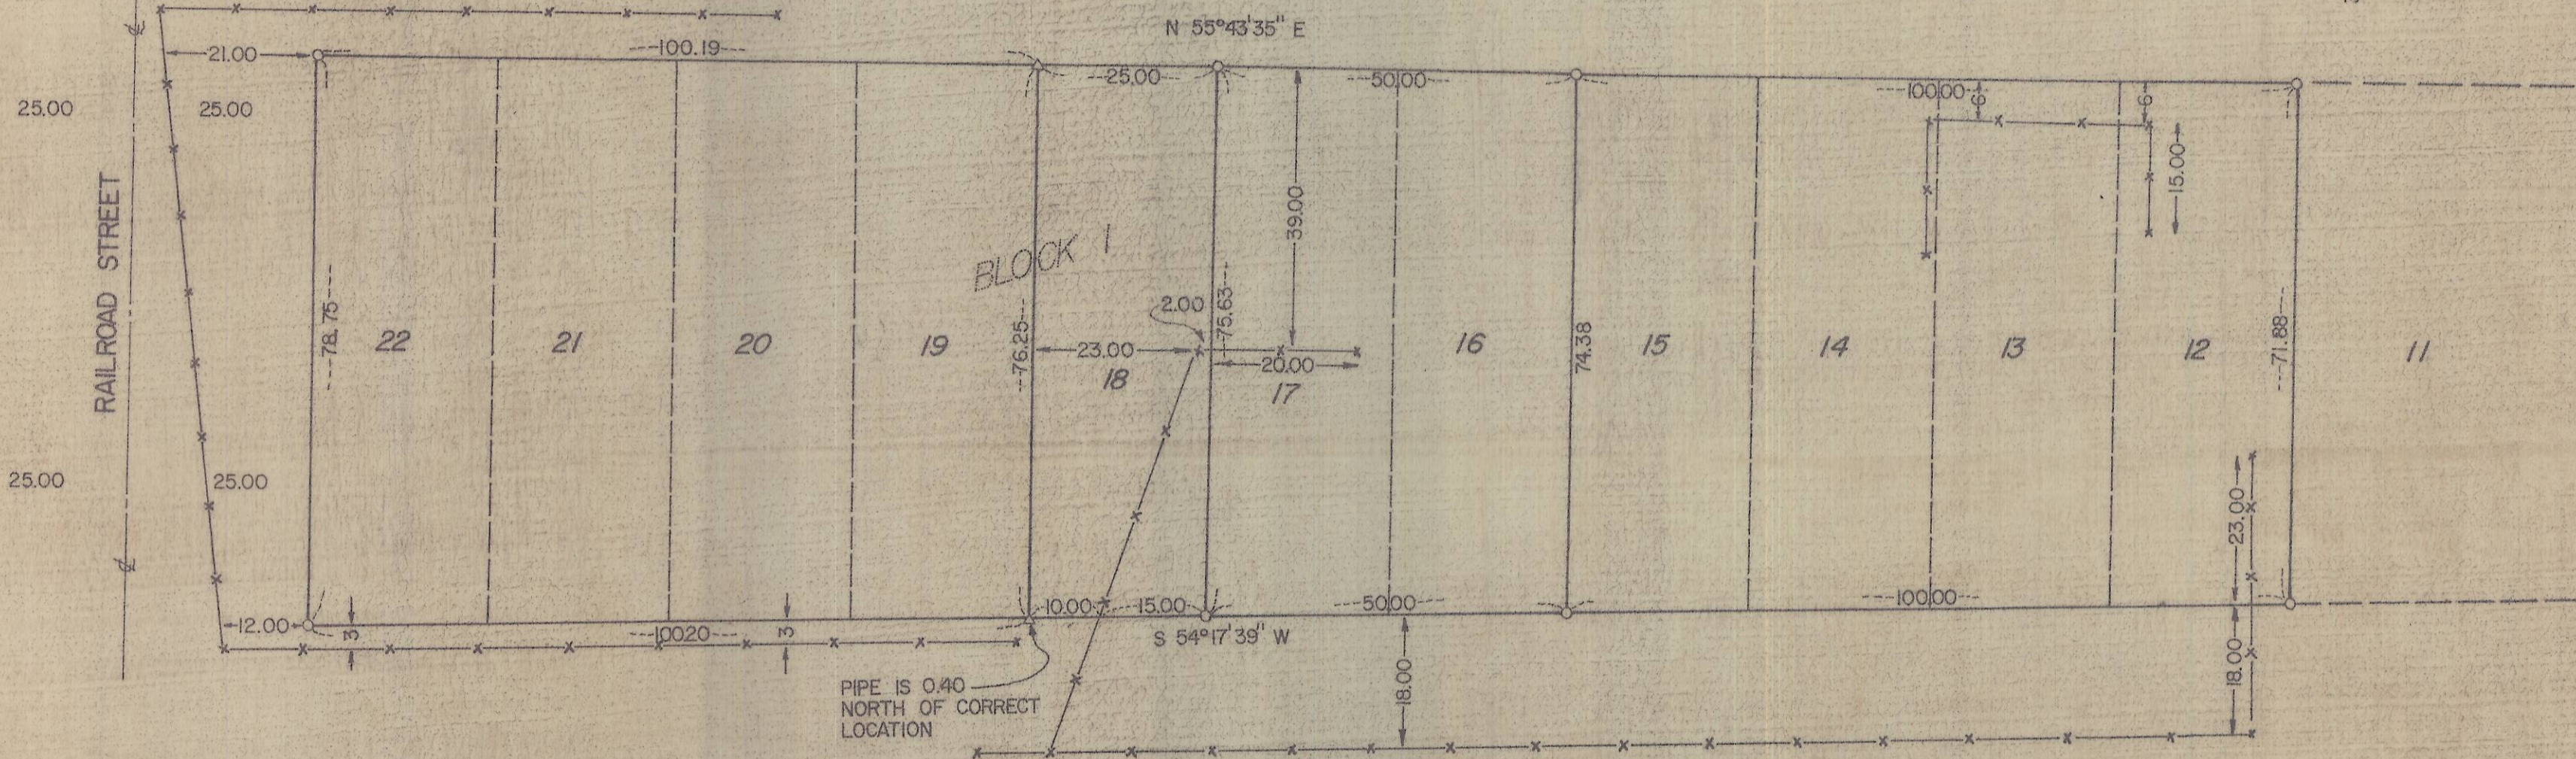

LEGEND

- SET 1/2" I. PIN
- ▲ FND. 3/4" PIPE
- FND. BRASS CAP

NOTE:

BEARINGS AND DISTANCES BASED
ON PLAT OF GEANAKOPOLOS
ADDITION TO DORIS.

PIPE IS 0.40
NORTH OF CORRECT
LOCATION

REGISTERED
PROFESSIONAL
LAND SURVEYOR
David H. Krumb
DAVID H. KRUMBEIN
1953

KRUMBEIN ENGINEERING CO.

ENGINEERS - SURVEYORS - PLANNERS
216 S.E. 1st, Pendleton, Oregon

SURVEY FOR
CASS, SPOUR, & MEACHAM
BLOCK 1, GEANAKOPOLOS
ADDITION TO DORIS

SCALE
1" = 20'
DATE
8-10-76
DRN. BY
T.E.H.
CKD. BY
D.H.K.
DRNG. NO.
76-47 C

L-46

L-46-B