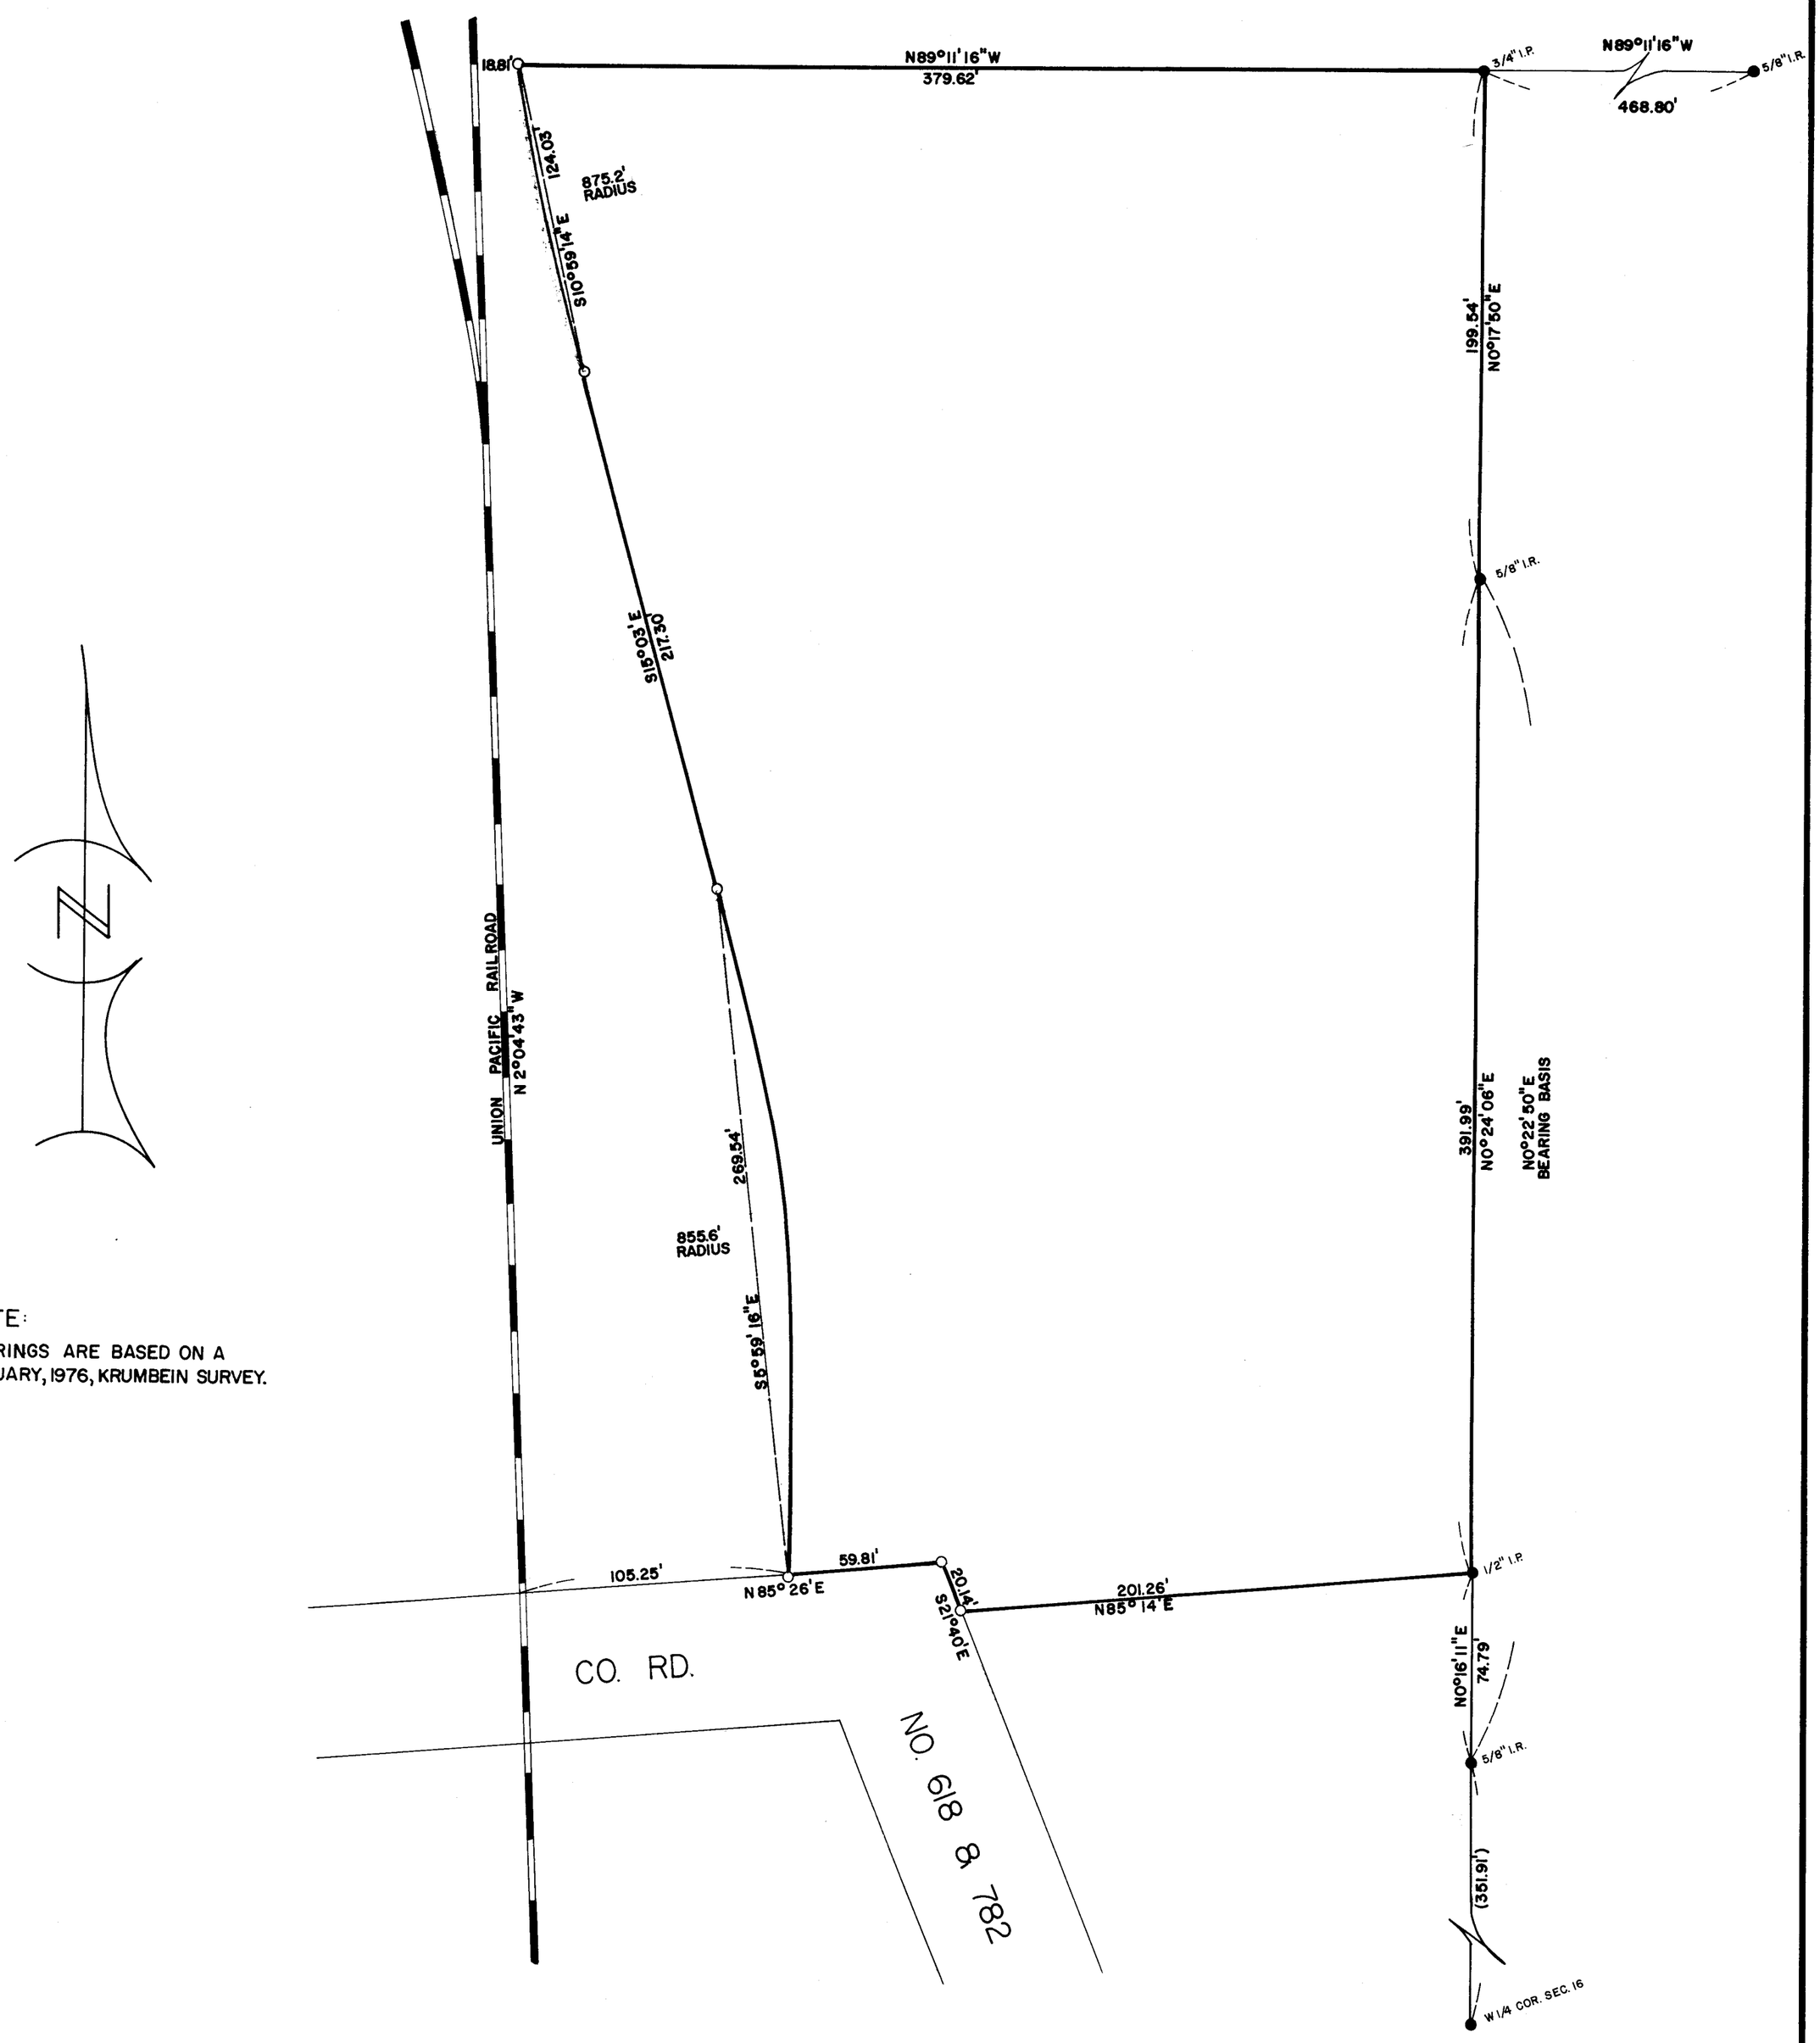

NOTE:
BEARINGS ARE BASED ON A JANUARY, 1976, KRUMBEIN SURVEY.

L-074-B

REGISTERED PROFESSIONAL LAND SURVEYOR
G. Dennis Edwards
OREGON
JULY 16, 1971
G. DENNIS EDWARDS
951

SURVEY FOR TOM O'BRIEN

LOCATION: NE 1/4

SEC. 17, T 5 N, R 28 E, W.M., UMATILLA COUNTY, OREGON

DATE: 8-30-76 SCALE: 1" = 50'

● MONUMENTS FOUND (000) OF RECORD

o 1/2" IRON RODS SET JOB NO. S7608202

EDWARDS SURVEYING
567-3336

P. O. Box 763
Hermiston, Ore.

S7608202