

36

31

32

33

34

R34E  
R35E  
FENCE CORNER  
T5N  
T4N  
N89°48'05"E 5331.93

SET BRASS CAP  
N89°47'15"E 5331.92

SET BRASS CAP  
N89°46'20"E 5331.92

N89°45'40"E 2665.98  
ROAD INTERSECTION

520.74

347.82

547.80

621.08

6

5


4

3

1" = 2000'

NOTE:  
BEARINGS AND DIST. SHOWN ARE  
TRUE, BASED UPON TIES TO  
N.G.S. STATION "ATHENA".

6	5
7	18

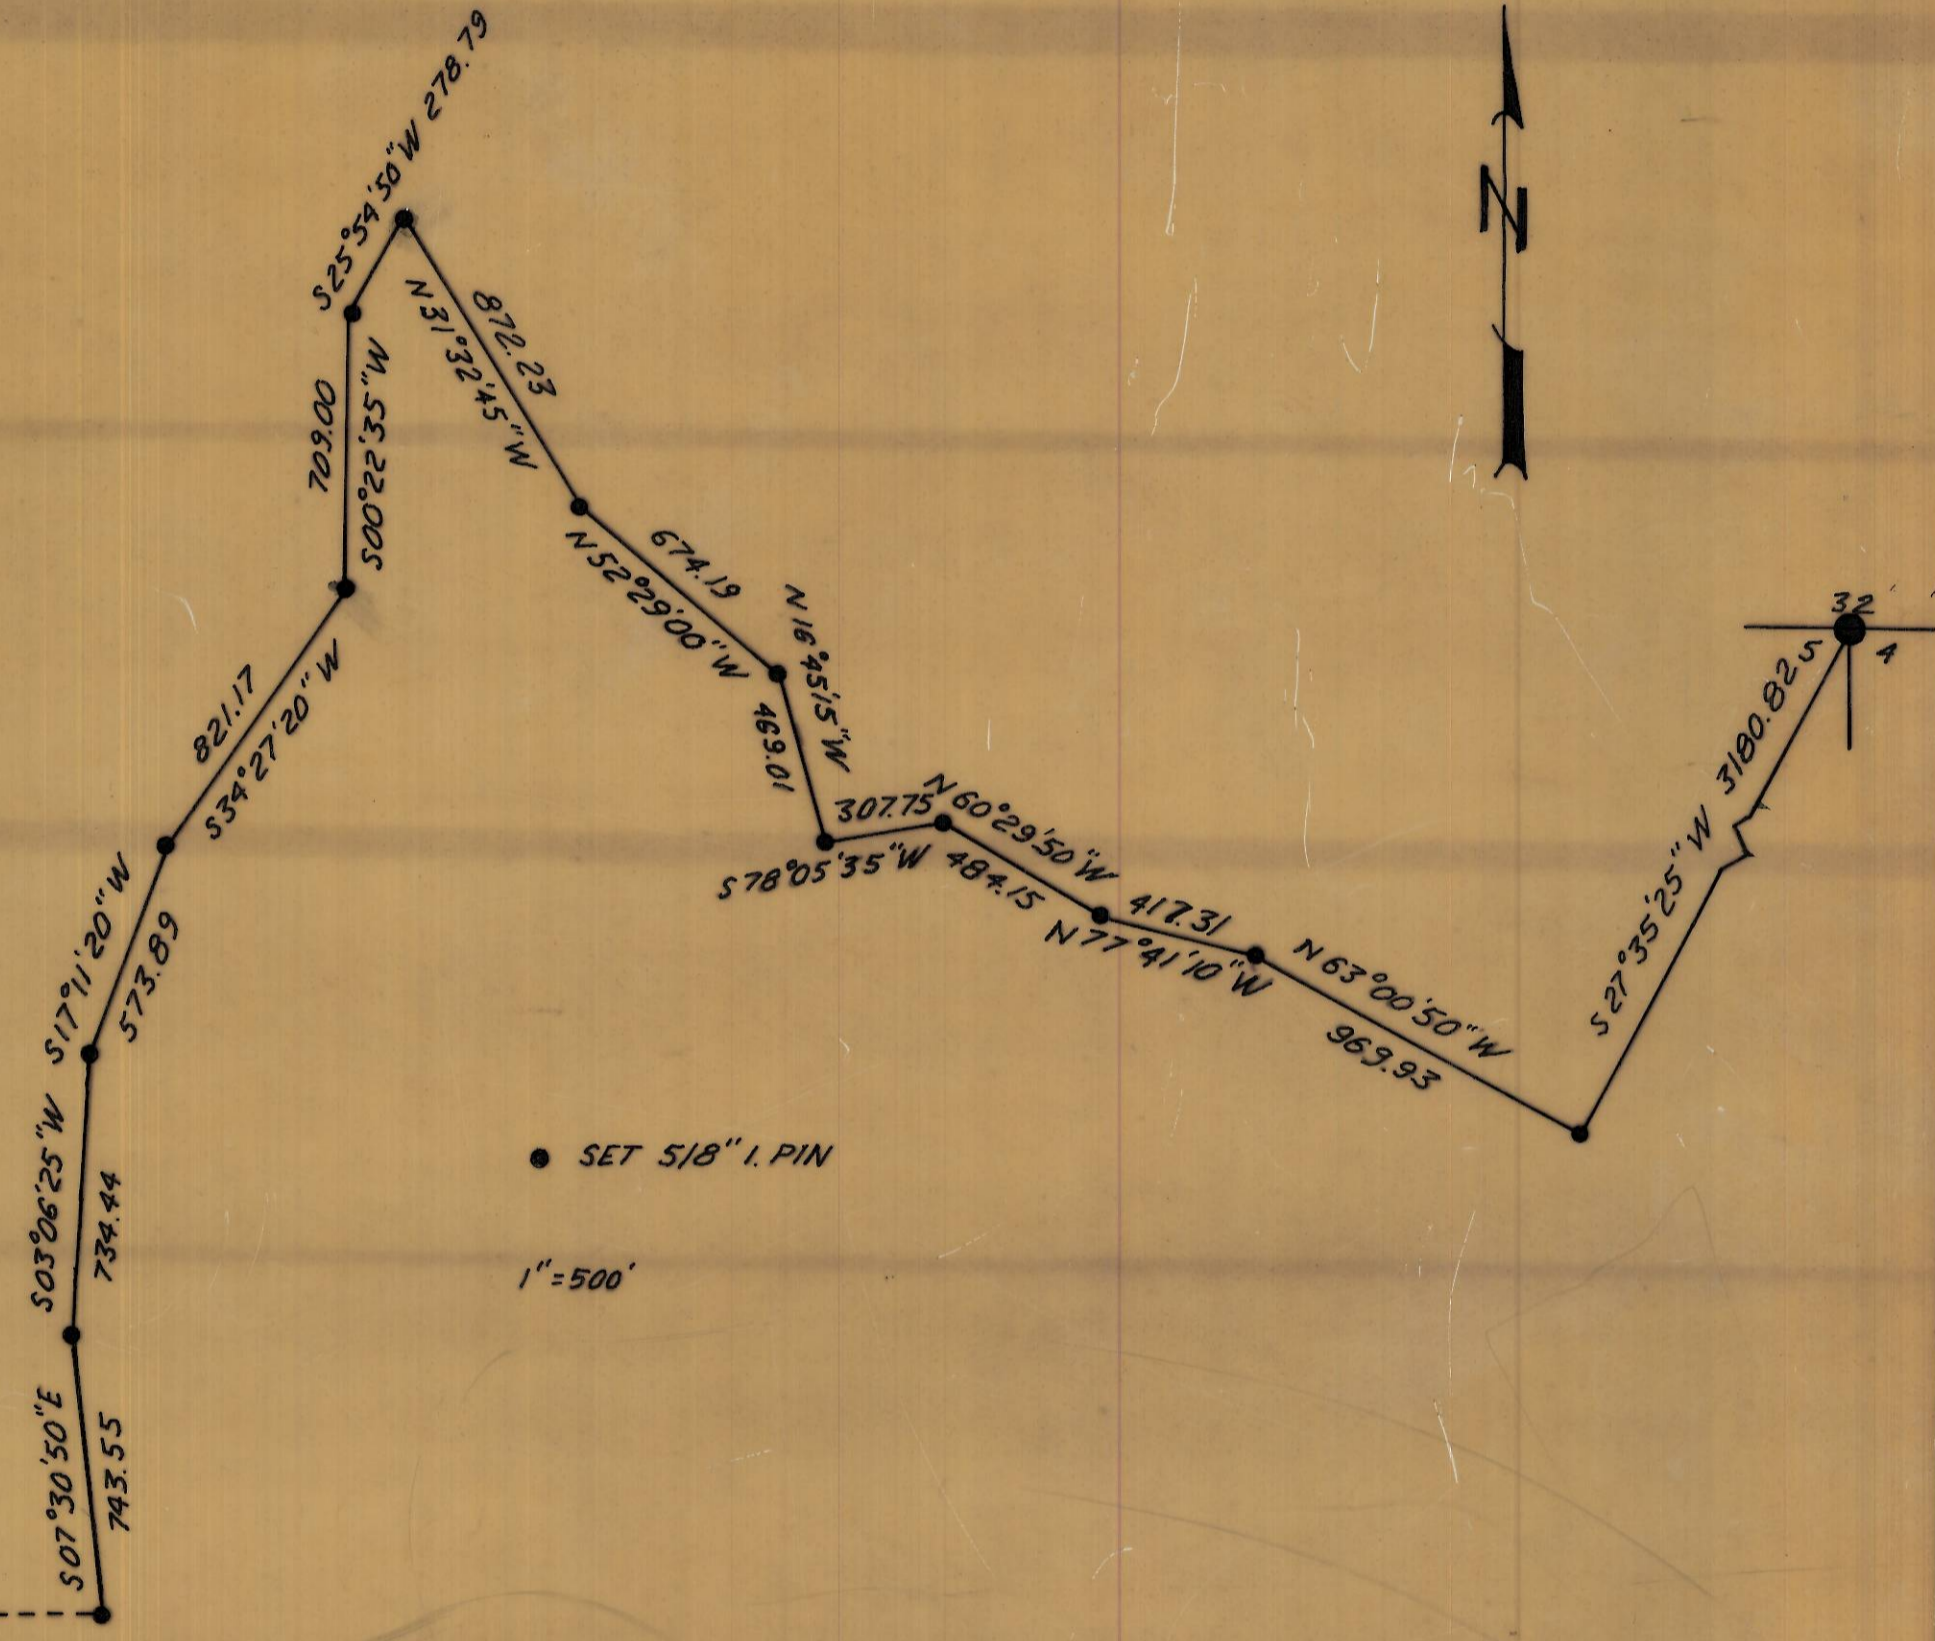

● SET 5/8" I. PIN

1" = 500'

REGISTERED  
PROFESSIONAL  
LAND SURVEYOR  
*David H. Krumbain*  
OREGON  
DAVID H. KRUMBEIN  
933

<b>KRUMBEIN ENGINEERING CO.</b>	
ENGINEERS - SURVEYORS - PLANNERS 216 S.E. 1st, Pendleton, Oregon	
SCALE AS SHOWN	DATE 27 DEC. 76
SURVEY FOR: GRANT KEY LINE IN SECTION 5 T.4N., R.35E., W.4M.	
DRN. BY J.L.C.	CKD. BY D.H.K.
DRNG. NO. 76-75 C	

M-27 M-120-B