


LOT 3, BLK 3  
RICHARD'S ADD.  
TO THE CITY  
OF ATHENA.

• SET 5/8" I. PIN

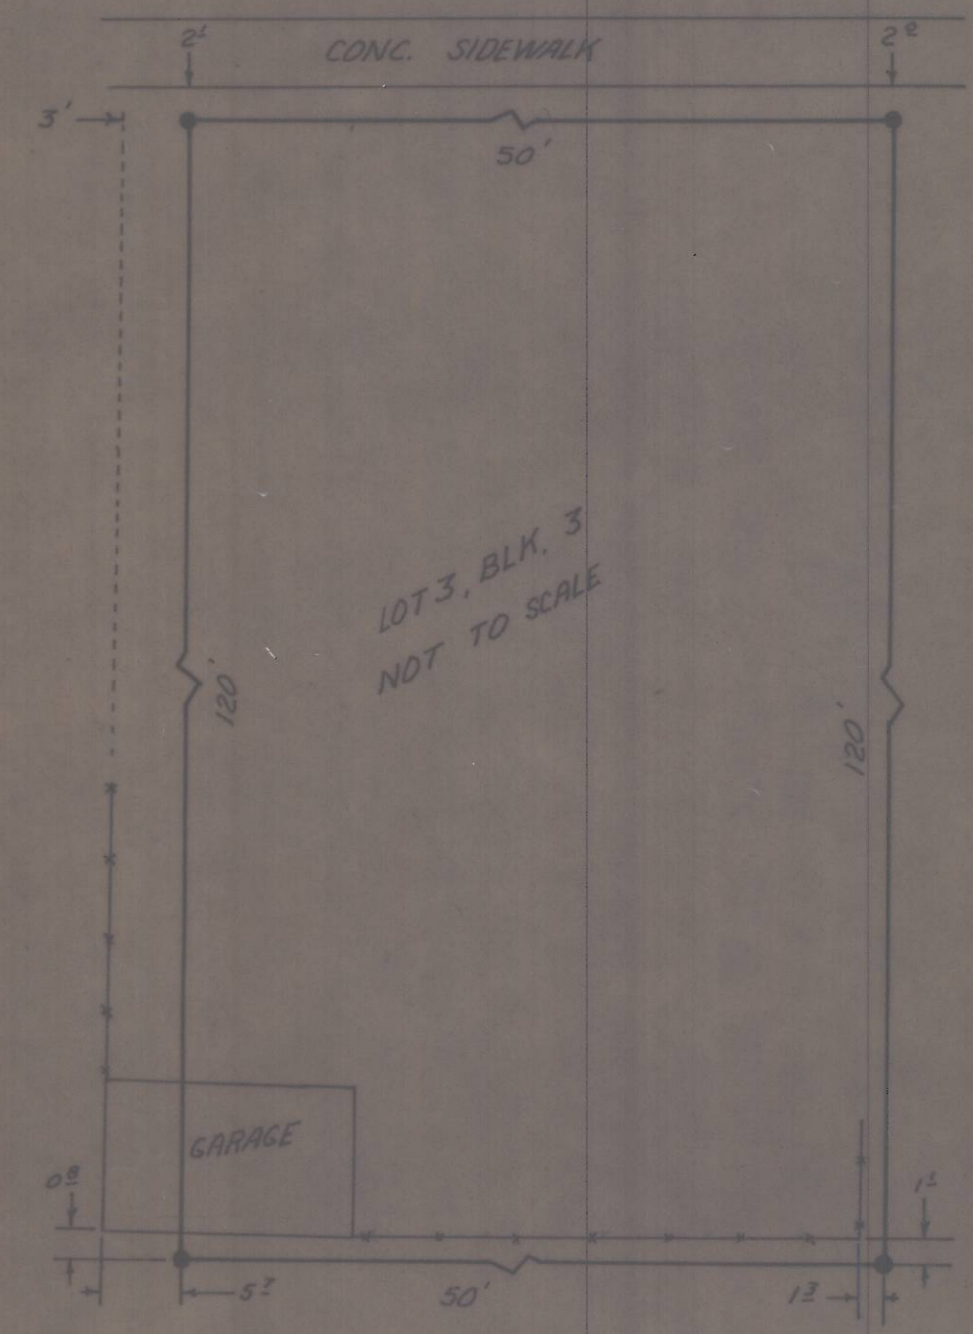

<b>KRUMBEIN ENGINEERING CO.</b>		SCALE 1"=20'
ENGINEERS - SURVEYORS - PLANNERS 216 S.E. 1st, Pendleton, Oregon		DATE 10 MAR 77
SURVEY FOR JERRY WEIDERT LOT 3, BLK 3 RICHARD'S ADD. TO THE CITY OF ATHENA, OREGON		DRN. BY JLC
		CKD. BY DHK
		DRNG. NO. 77-136

N-70-B

N 71-50-B