CADASTRAL SURVEY

Portion of

SEC'S 28, 33 & 34, T4N. R37E WM.

UMATILLA COUNTY OREGON

Harris Pine Mills Inc.

Pendleton, Oregon

Scale 1" = 1000' Date 10-31-78

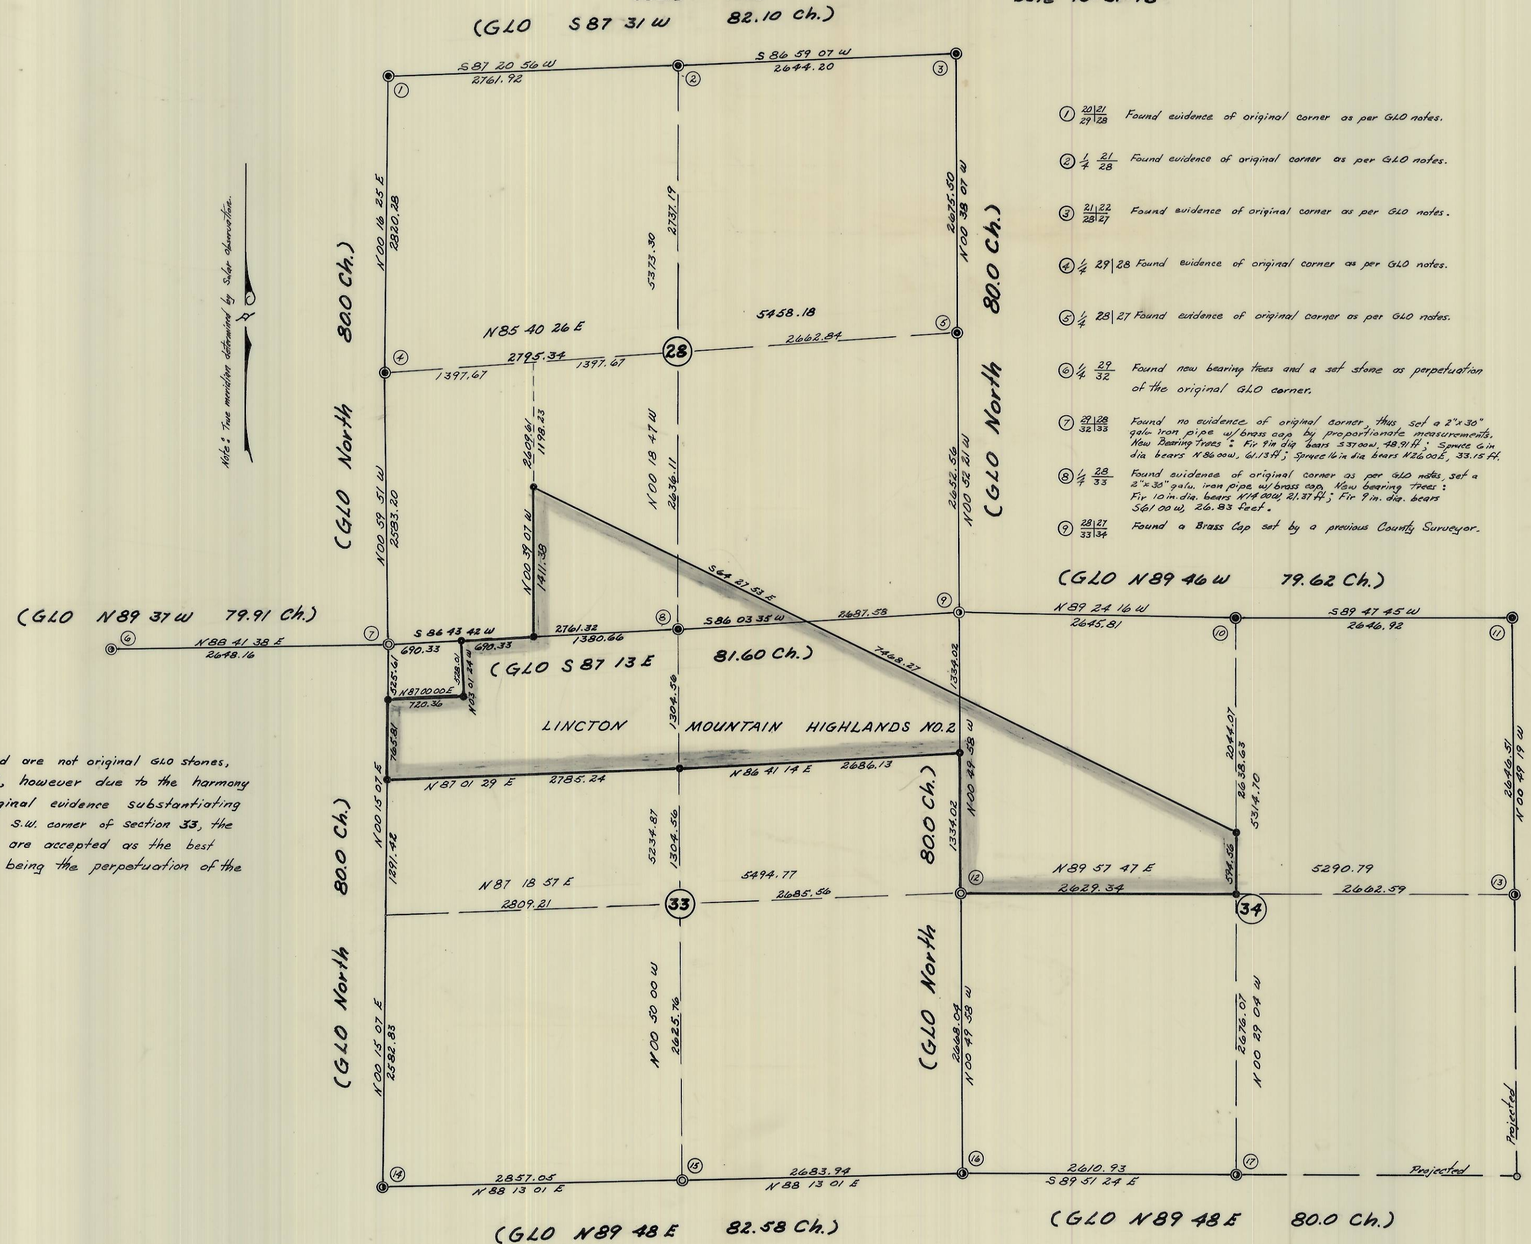


2) 1/4 21/28 Found evidence of original corner as per GLO notes.

3) 21/22 | 28/27 Found evidence of original corner as per GLO notes.

4) 1/4 29/28 Found evidence of original corner as per GLO notes.

5) 1/4 28/27 Found evidence of original corner as per GLO notes.

6) 1/4 29/32 Found new bearing trees and a set stone as perpetuation of the original GLO corner.

7) 29/28 | 32/33 Found no evidence of original corner, thus set a 2"x30" galv. iron pipe w/brass cap by proportionate measurements. New Bearing Trees: Fir 9in dia bears S 37 00 W 48.9 ft; Spruce 6 in dia bears N 86 00 W, 61.13 ft; Spruce 16 in dia bears N 26 00 E, 33.15 ft.

8) 1/4 28/33 Found evidence of original corner as per GLO notes. Set a 2"x30" galv. iron pipe w/brass cap, New bearing trees: Fir 10 in. dia. bears N 14 00 W 21.37 ft; Fir 9 in. dia. bears S 61 00 W, 26.83 feet.

9) 28/27 | 33/34 Found a Brass Cap set by a previous County Surveyor.

10) 1/4 27/34 Found evidence of original corner as per GLO notes.

11) 27/26 | 34/35 Found evidence of original corner as per GLO notes.

12) 1/4 33 | 34 Found no acceptable evidence of original corner, set a 2"x30" galv. iron pipe w/ brass cap by proportionate measurements. New bearing trees: Fir 6 in. dia. bears S 38 00 W, 96.83 ft; Spruce 9 in. dia. bears N 68 00 E, 25.07 feet.

13) 1/4 34 | 35 Found an 1 1/2" iron pipe, being used as the actual 1/4 corner and is harmonious with the G.L.O. calls about the 1/4 corner.

14) 32/33 | 5/4 Found remnance of face with scribing N R37E S and a set stone marked with 6 notches on south and an x on top of the stone as perpetuation of the original corner.

15) 1/4 33/4 Found no evidence of original corner, set 2"x30" galv. iron pipe w/brass cap by proportionate measurements. New bearing trees: Fir 7 in. dia. bears N 32 00 E, 60.55 feet; Fir 9 in. dia. bears S 65 00 W, 40.66 feet.

16) 33/34 | 4/3 Found a set stone 25"x10"x4", 14 in. in ground as the perpetuation of the original corner.

17) 1/4 34/3 Found a small mound of stone in a small glade as per GLO notes with the mound as a perpetuation of the original corner.

NOTE:

Stones shown as found are not original GLO stones, and are un-recorded, however due to the harmony between stones & original evidence substantiating the stone set at the S.W. corner of section 33, the stones noted herein are accepted as the best available evidence as being the perpetuation of the original GLO corners.

LEGEND:

- ◉ Found evidence of original GLO corner.
- ◎ Found perpuation of original GLO corner.
- ◎ Set 2"x 30" galv. iron pipe w/Brass cap by proportionate measurements.
- ● Set 1"x 30" galv. iron pipe w/brass cap
- ○ Projected point.

SURVEYOR'S STATEMENT:

I, Douglas M. Ferguson, being a registered Professional Land Surveyor in the State of Oregon, do hereby certify that this map correctly represents a survey preformed by me or under my direction, for Harris Pine Mills Inc., using public and private records, and in accordance with the BLM manual and the statutes of the State of Oregon.

Douglas M Ferguson 10-31-78
ORLS # 848

REGISTERED PROFESSIONAL LAND SURVEYOR
OREGON
JULY 12, 1968
DOUGLAS M. FERGUSON
848

OREGON EAST ENGINEERING, INC.		
Survey in Sec's 28, 33 & 34 T4N, R37E, W.M. UMATILLA COUNTY, ORE.		
FOR: Harris Pine Mills Inc.	BY: D.M.F & J.H.H	
DATE: 10/78	DRAWING NO:	SHEET 1 of 1
SCALE: 1"=1000'	JOB NO.:	DRAWN BY: J.H.H.

P-113-B