


Q 459-B
20364
OR 19

REGISTERED
OREGON
LAND SURVEYOR

Ralph P. Thompson

MAY 13, 1940
RALPH P. THOMPSON
506

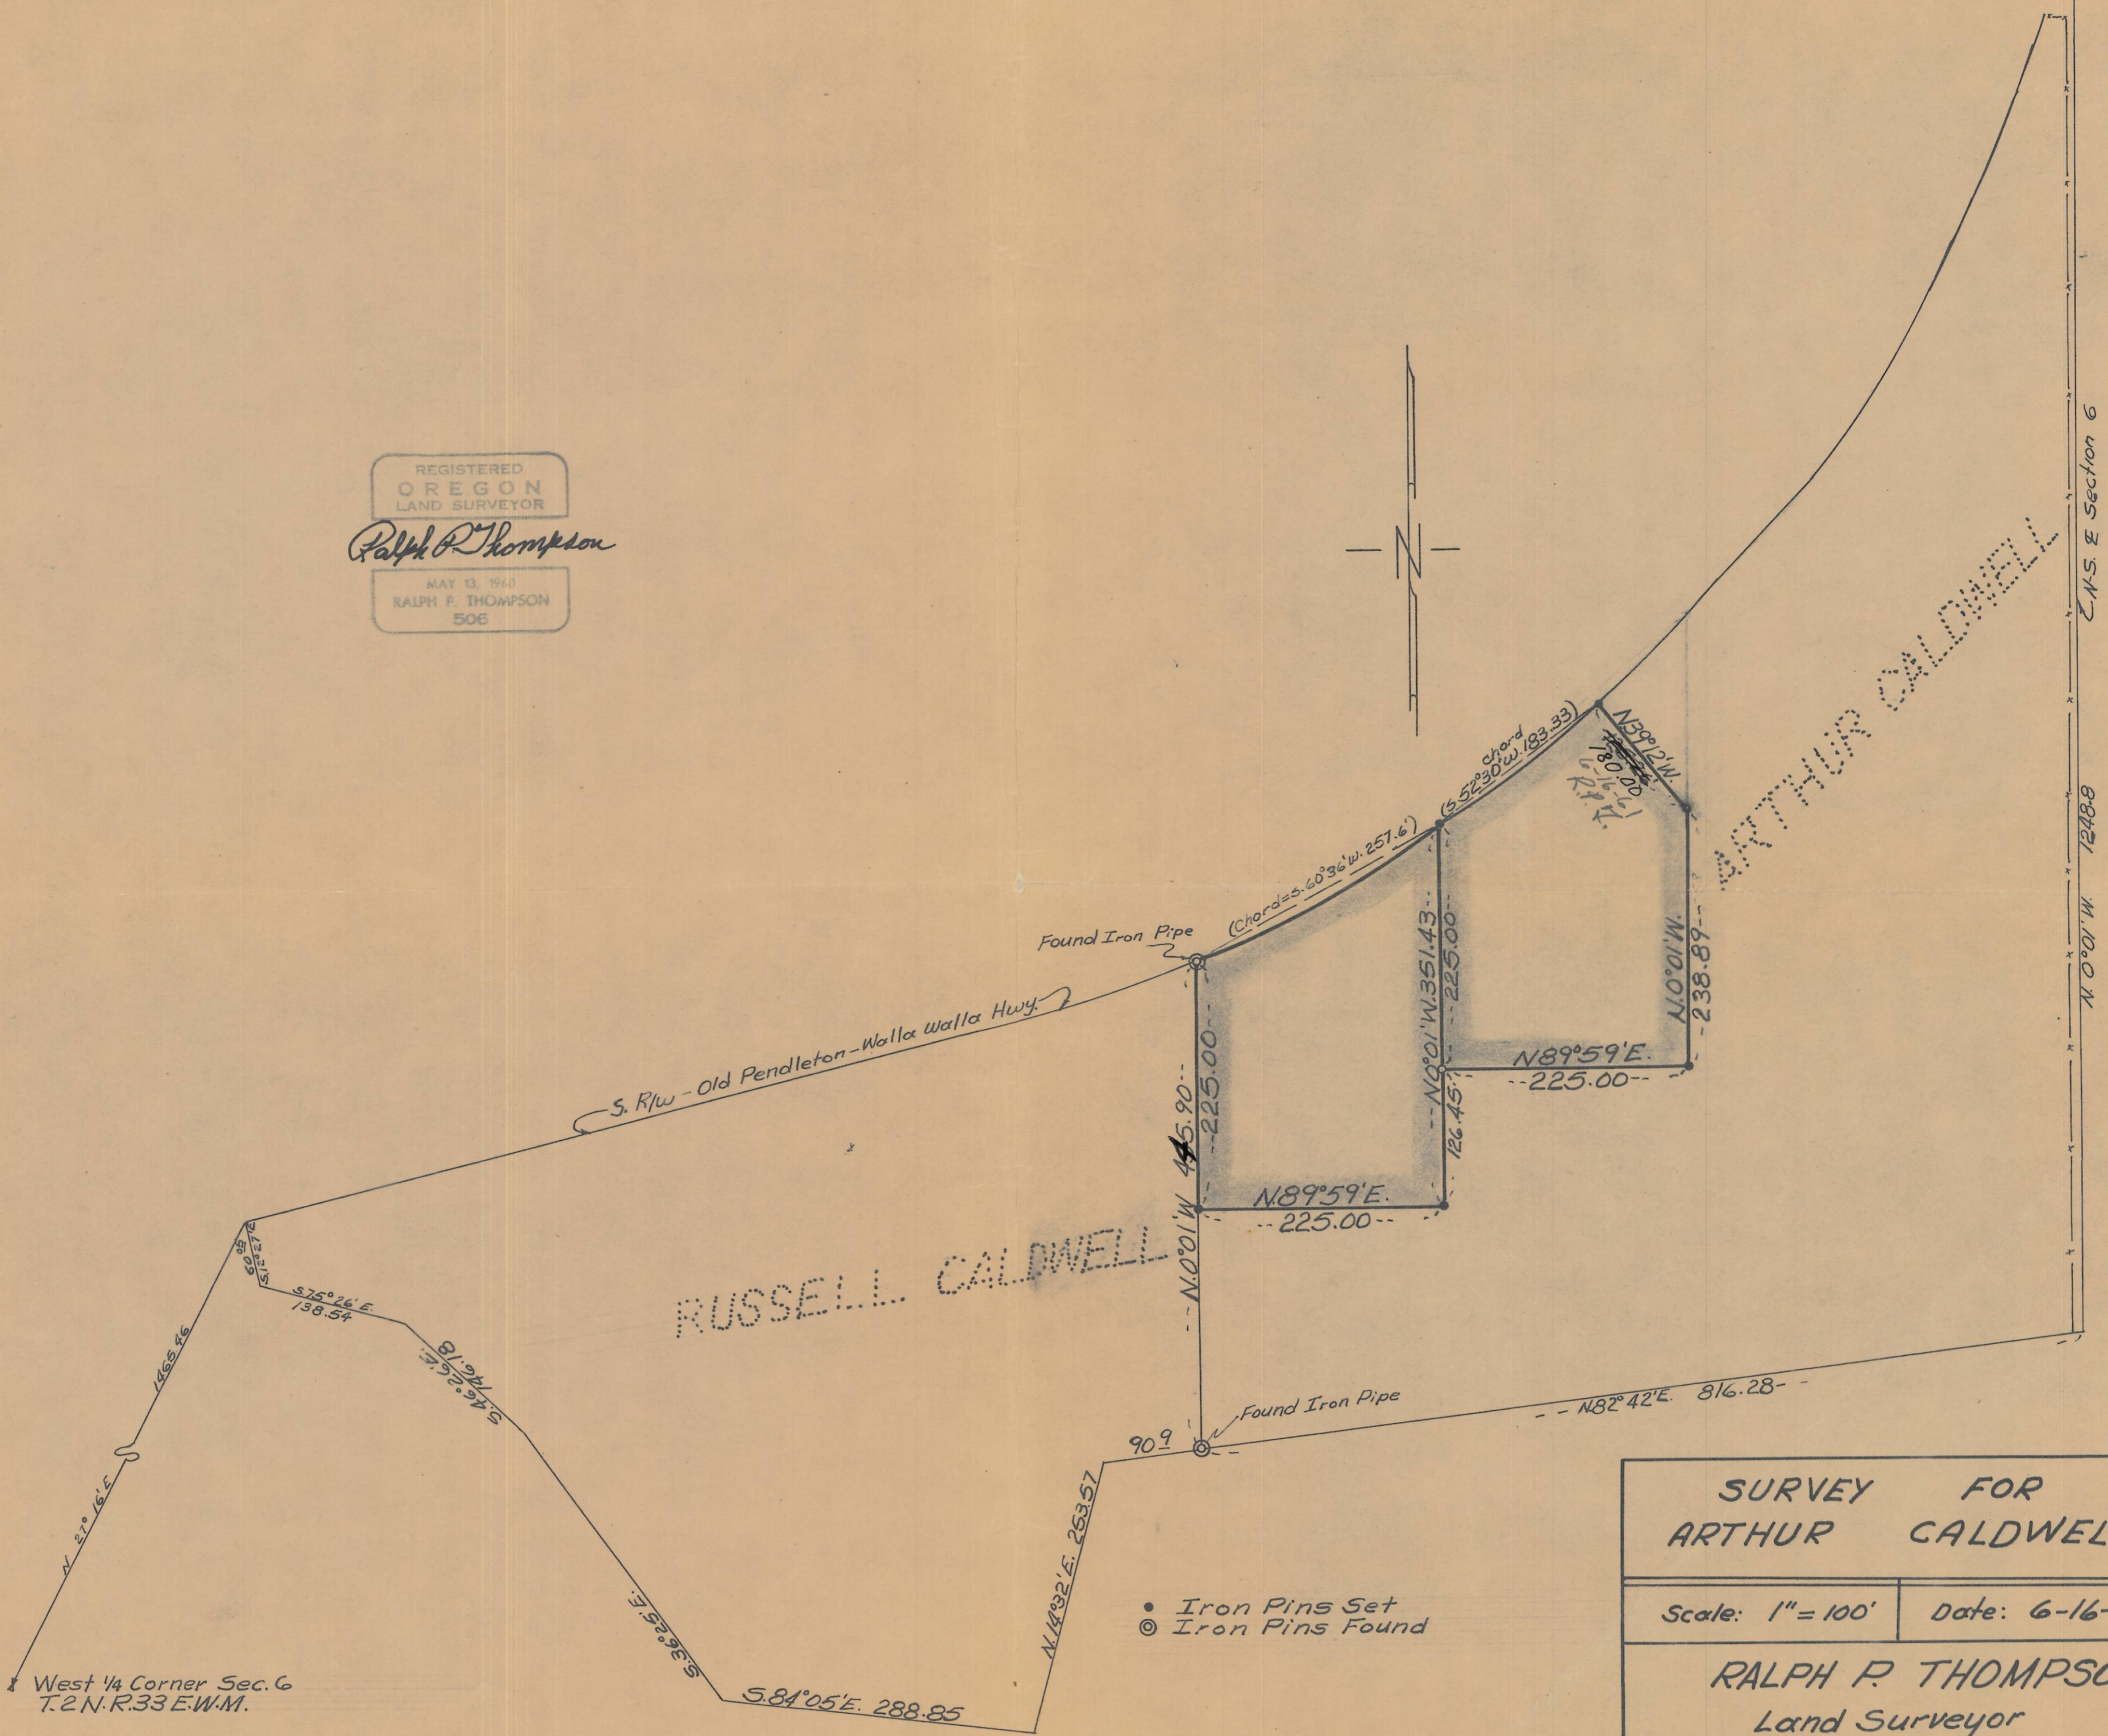

RUSSELL CALDWELL

ARTHUR CALDWELL

SURVEY FOR ARTHUR CALDWELL	
Scale: 1" = 100'	Date: 6-16-61
RALPH P. THOMPSON Land Surveyor	
Pendleton	Oregon

• Iron Pins Set
⊙ Iron Pins Found