


T. 2 N. R. 32 E.
T. 2 N. R. 33 E.

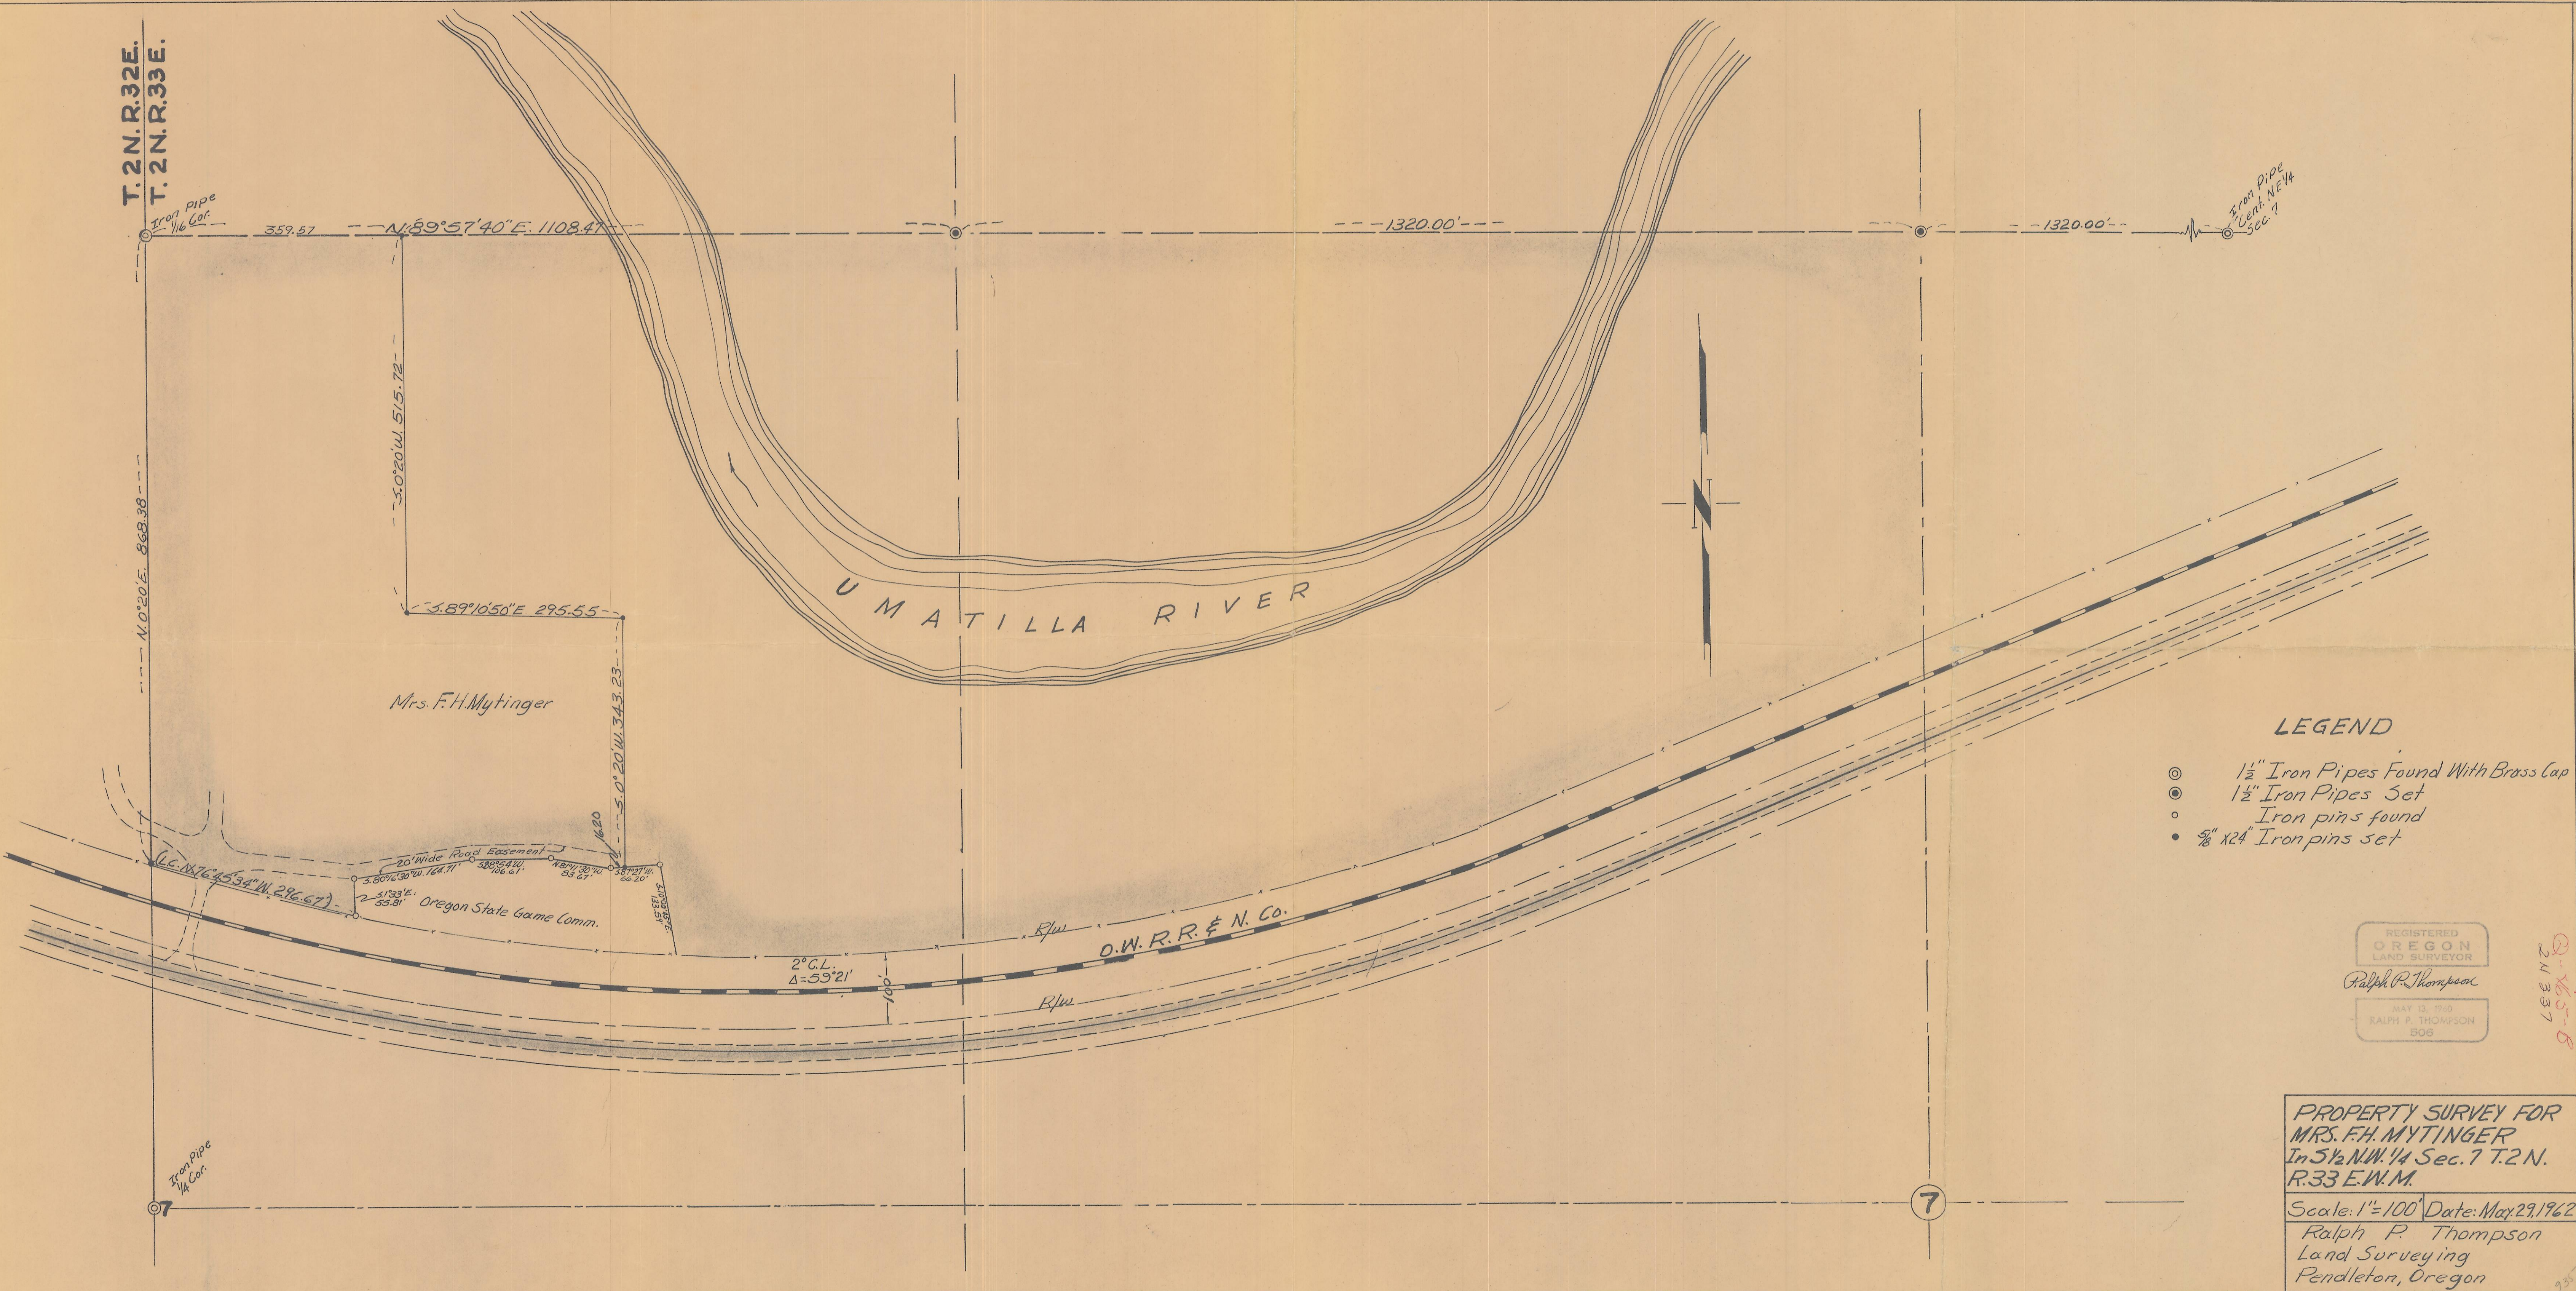

LEGEND

- ⊙ 1 1/2" Iron Pipes Found With Brass Cap
- ⊙ 1 1/2" Iron Pipes Set
- Iron pins found
- 5/8" x 24" Iron pins set

REGISTERED
OREGON
LAND SURVEYOR
Ralph P. Thompson
MAY 13 1960
RALPH P. THOMPSON
506

PROPERTY SURVEY FOR
MRS. F.H. MYTINGER
In 5 1/2 N.W. 1/4 Sec. 7 T. 2 N.
R. 33 E.W.M.
Scale: 1" = 100' Date: May 29, 1962
Ralph P. Thompson
Land Surveying
Pendleton, Oregon

2017
9-165-8
2N33E