


H-906-A

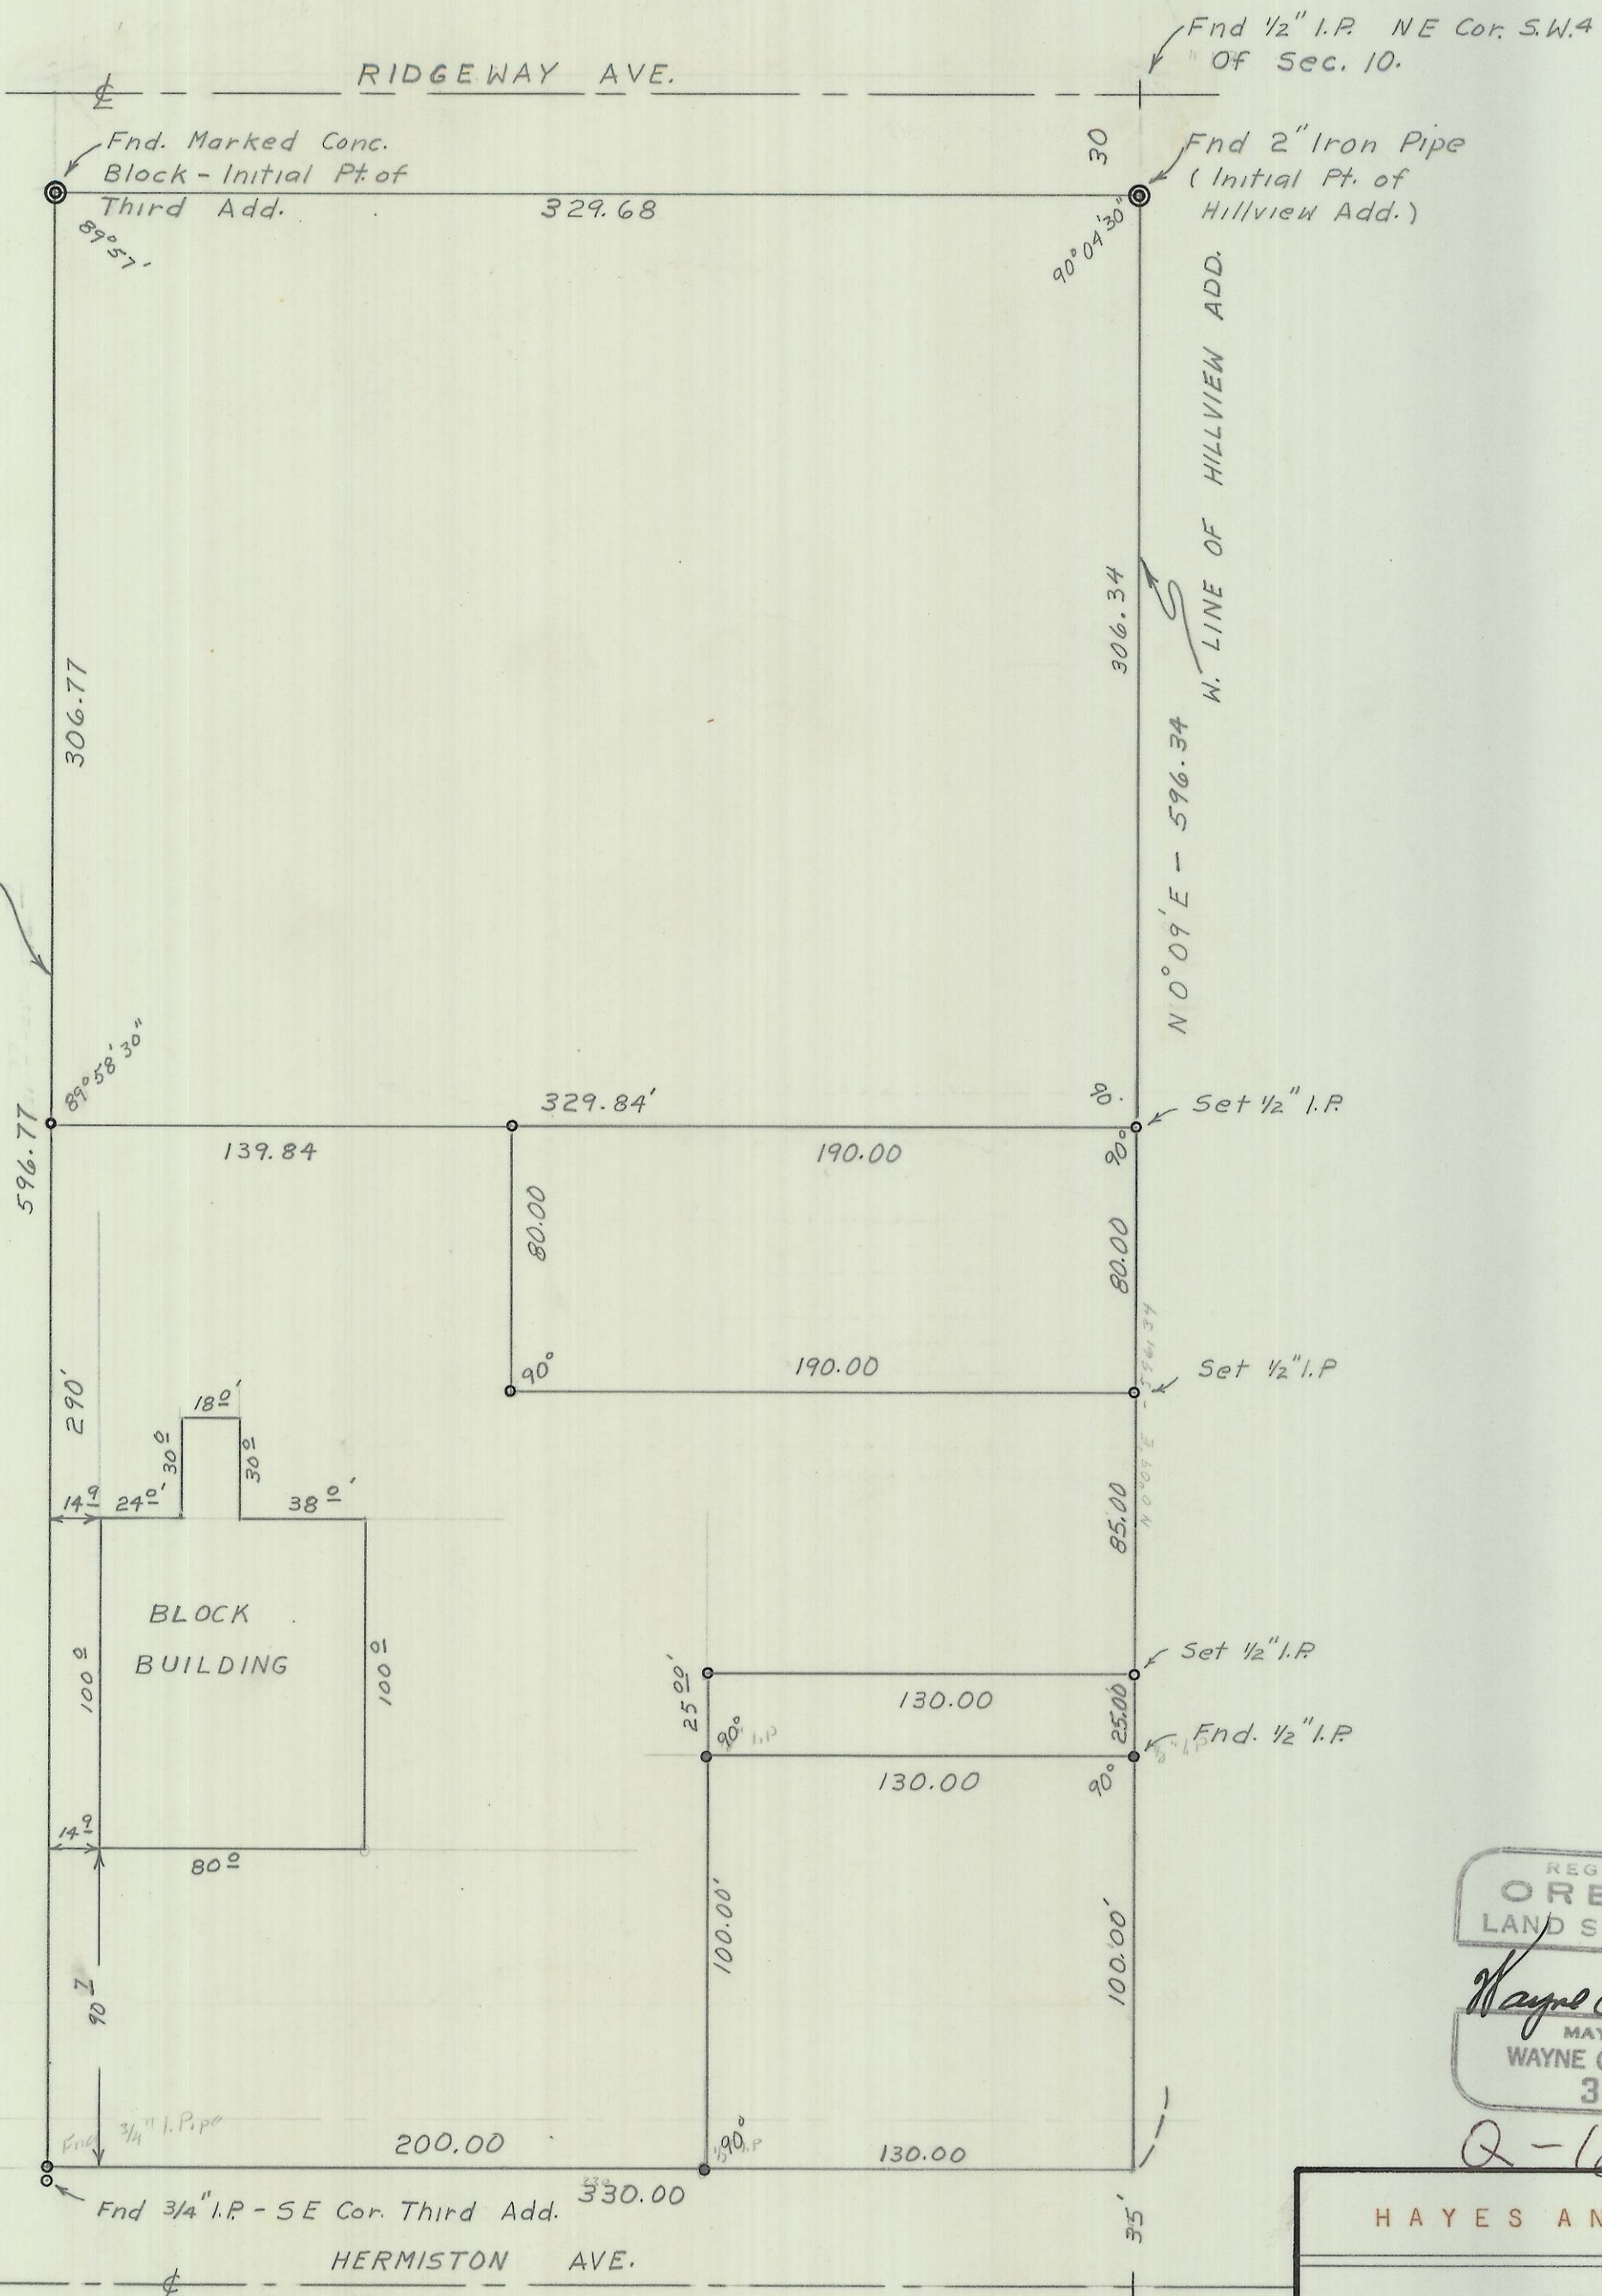

REGISTERED
OREGON
 LAND SURVEYOR

Wayne O. Harris

MAY 6, 1955
WAYNE O. HARRIS
 346

Q-1006-A

HAYES AND HARRIS			
SURVEY FOR KNIGHTS GROCERY			
PARCEL IN SEC. 10 T. 4 N., R. 28 E. W.M.			
SCALE	DATE	DRN. BY	DRNG. NO.
1" = 50'	3/15/63	WOH	63-137 A