


S.W. 1/4, SECTION 10, T.4N., R.28E.

SCALE: 1" = 400'

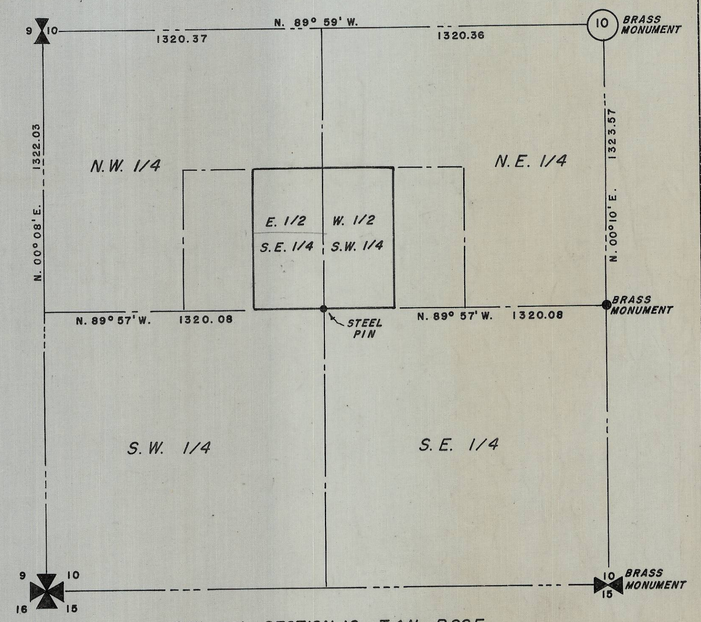


● CONCRETE MONUMENTS

REGISTERED PROFESSIONAL ENGINEER 2475 OREGON MARCH 10, 1950 FRANK ROBERT OFNER

Frank Robert Ofner

RECEIVED BY
Umatilla County Surveyor
Date 1-08
Rec'd by K.K
No. 08-005-C
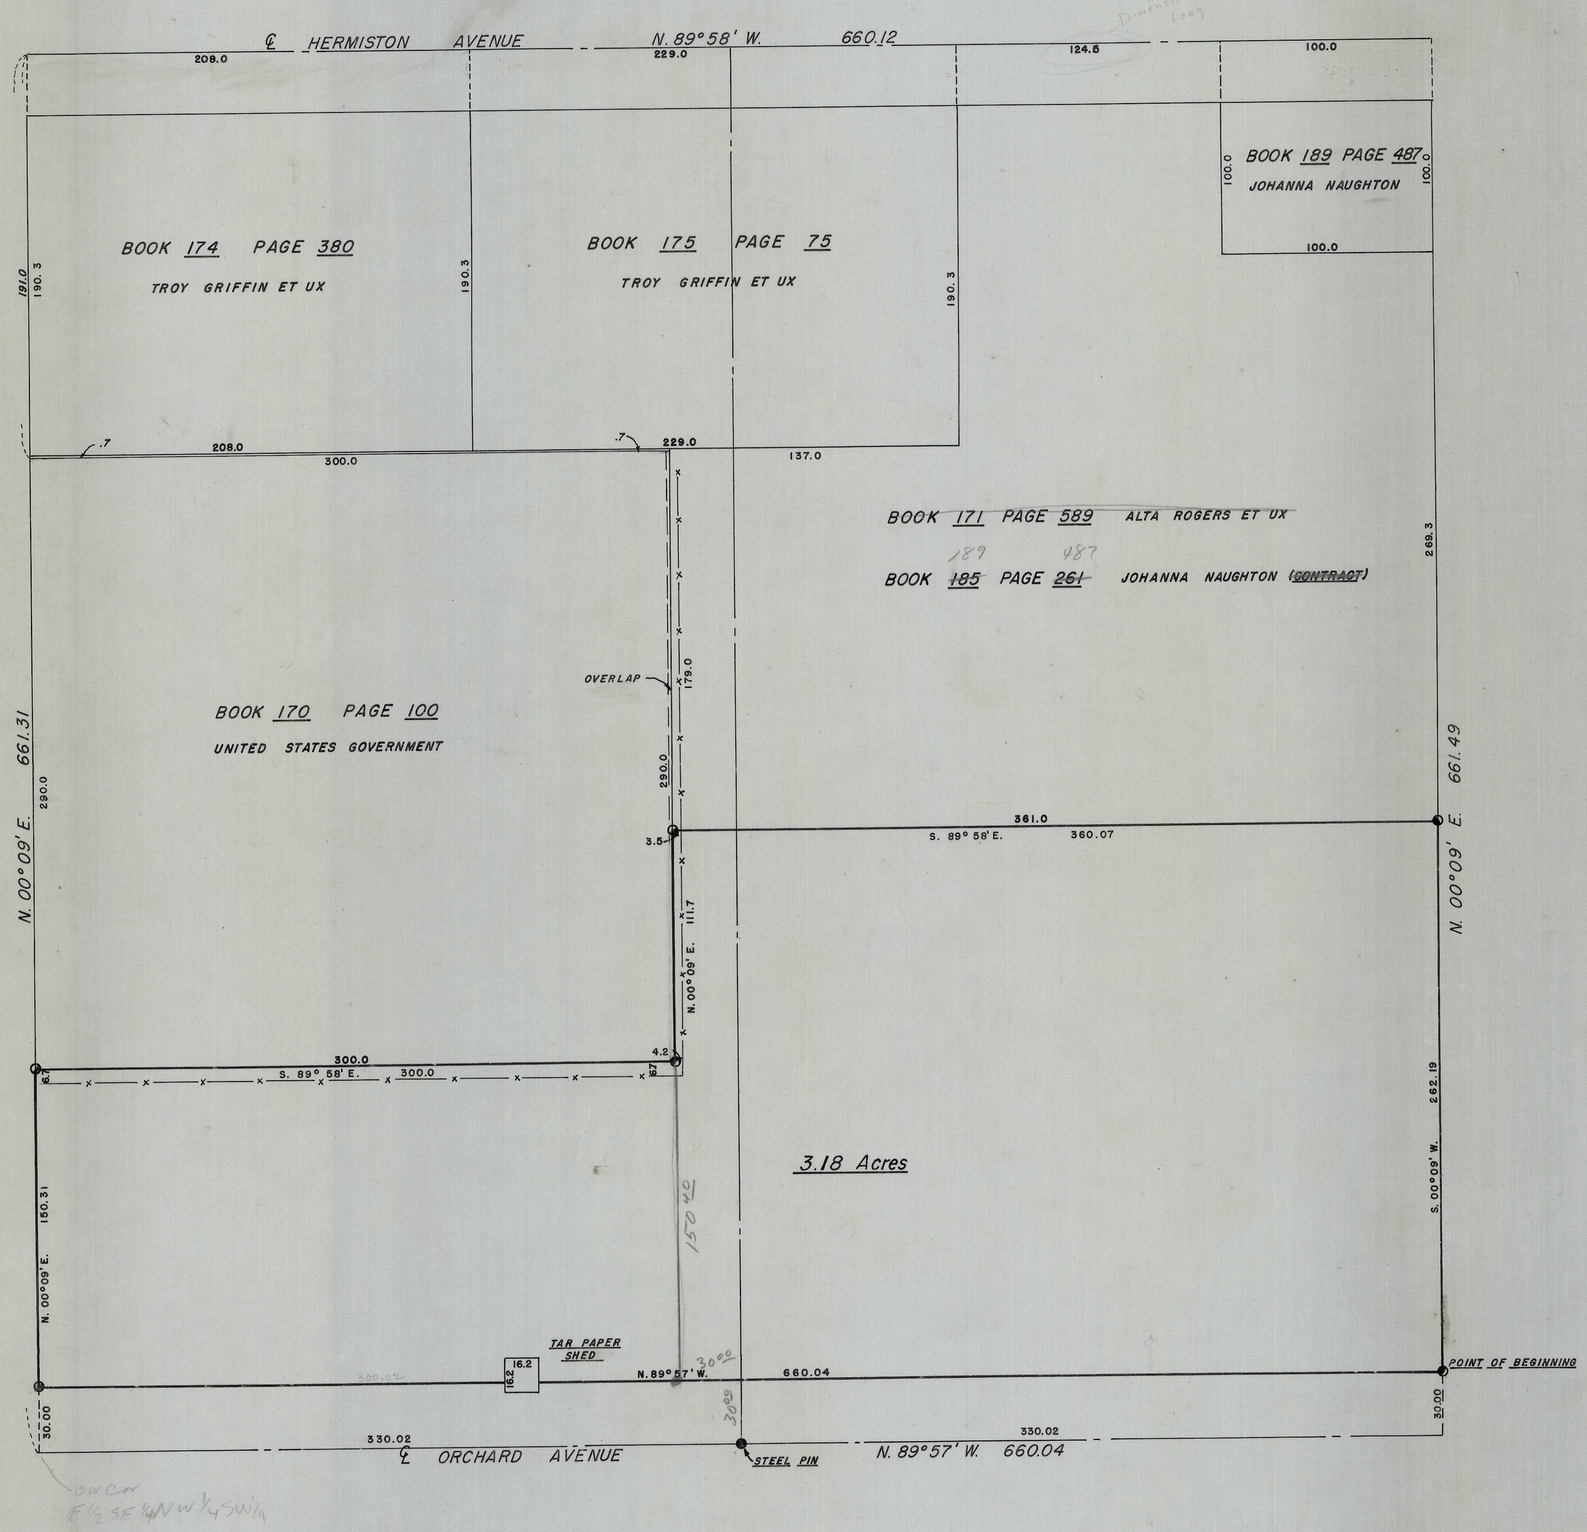
# PROPERTY LINE MAP
## LOW RENT HOUSING PROJECT
HOUSING AUTHORITY OF THE COUNTY OF UMATILLA, OREGON
CITY OF HERMISTON, UMATILLA COUNTY, OREGON

FRANK R. OFNER
REGISTERED ENGINEER

SCALE: 1" = 40'

JANUARY 10, 1951

PROJECT NO. ORE 7-1
PLAN NO.