

W 1/4 CORNER SEC. 4, T3N, R35E  
N 81° 20' 20" W 3230.03

N 62° 21' 20" E  
26.88

S 84° 26' 00" E  
136.16

S 58° 57' 50" E  
32.94

N 38° 17' 10" W  
407.09

S 81° 38' 30" E  
172.71

S 55° 48' 10" E  
232.62

S 63° 20' 50" E  
67.36

S 77° 10' 50" E  
150.87

S 82° 17' 10" E  
497.12

S 78° 31' 00" E  
223.61

S 77° 27' 00" E  
325.03

S 83° 06' 10" E  
197.66 m/L


N 66° 28' 00" W  
64.56

N 78° 16' 30" W  
353.34

N 86° 36' 20" W  
904.51

SOUTH  
776.50

3" I. PIPES SET AT ALL CORNERS

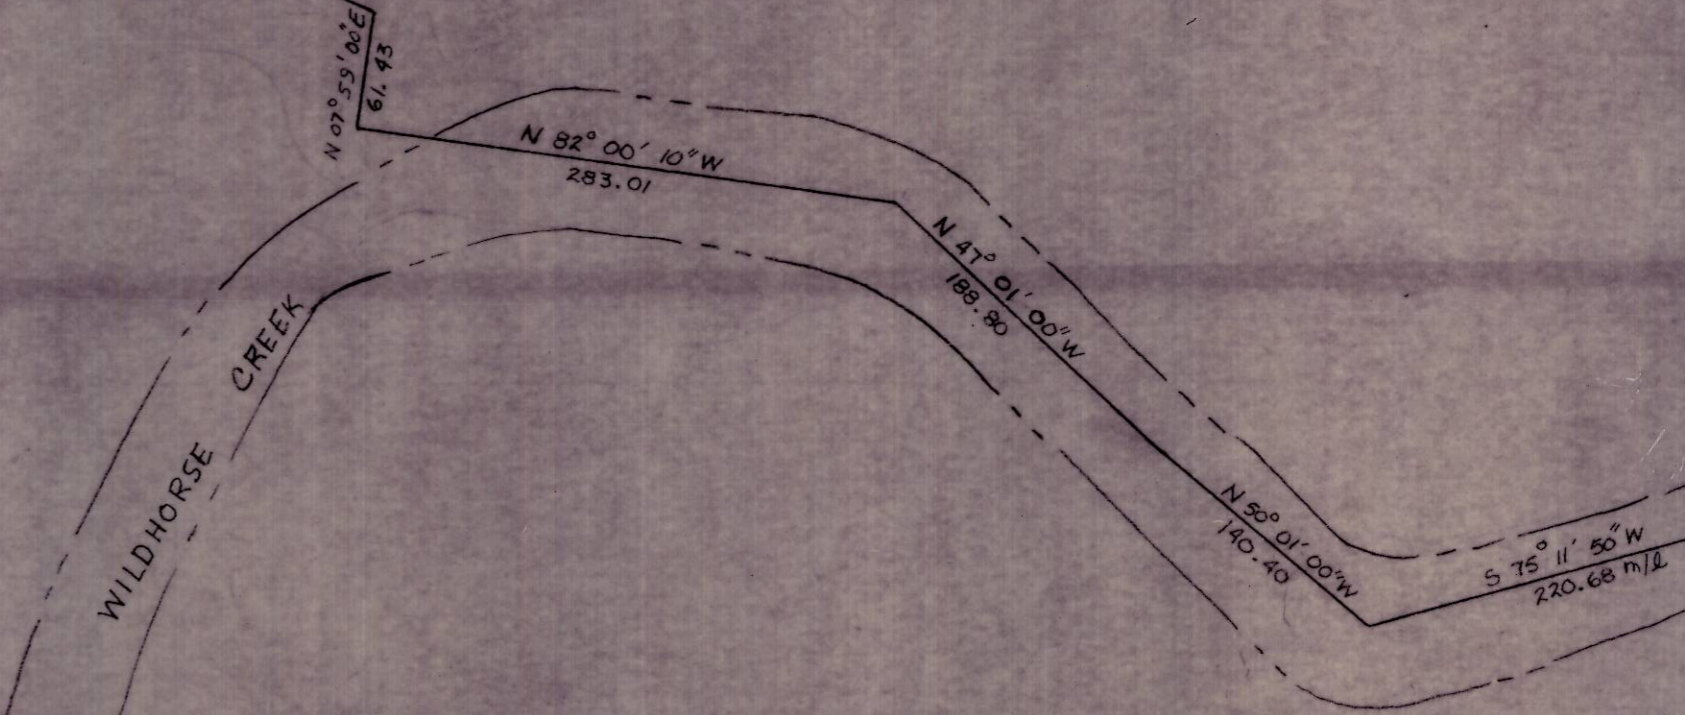

WAYNE HARRIS CO. INC.

SURVEY FOR  
ART BELL  
S. 1/2, SEC. 4, T.3N., R.35E., W.M.



SCALE	DATE	DRN. BY	DRNG. NO.
1" = 100'	8/2/73	DWB	73-336-C