



- NOTES:
1. TANK LOCATION SHOWN AS DESCRIBED BY OWNER
  2. UNDERGROUND UTILITY SERVICE LOCATIONS UNAVAILABLE
  3. MANHOLE "A" WAS USED FOR ELEVATION REFERENCE NORTH RIM ELEVATION = 1082.95 FEET

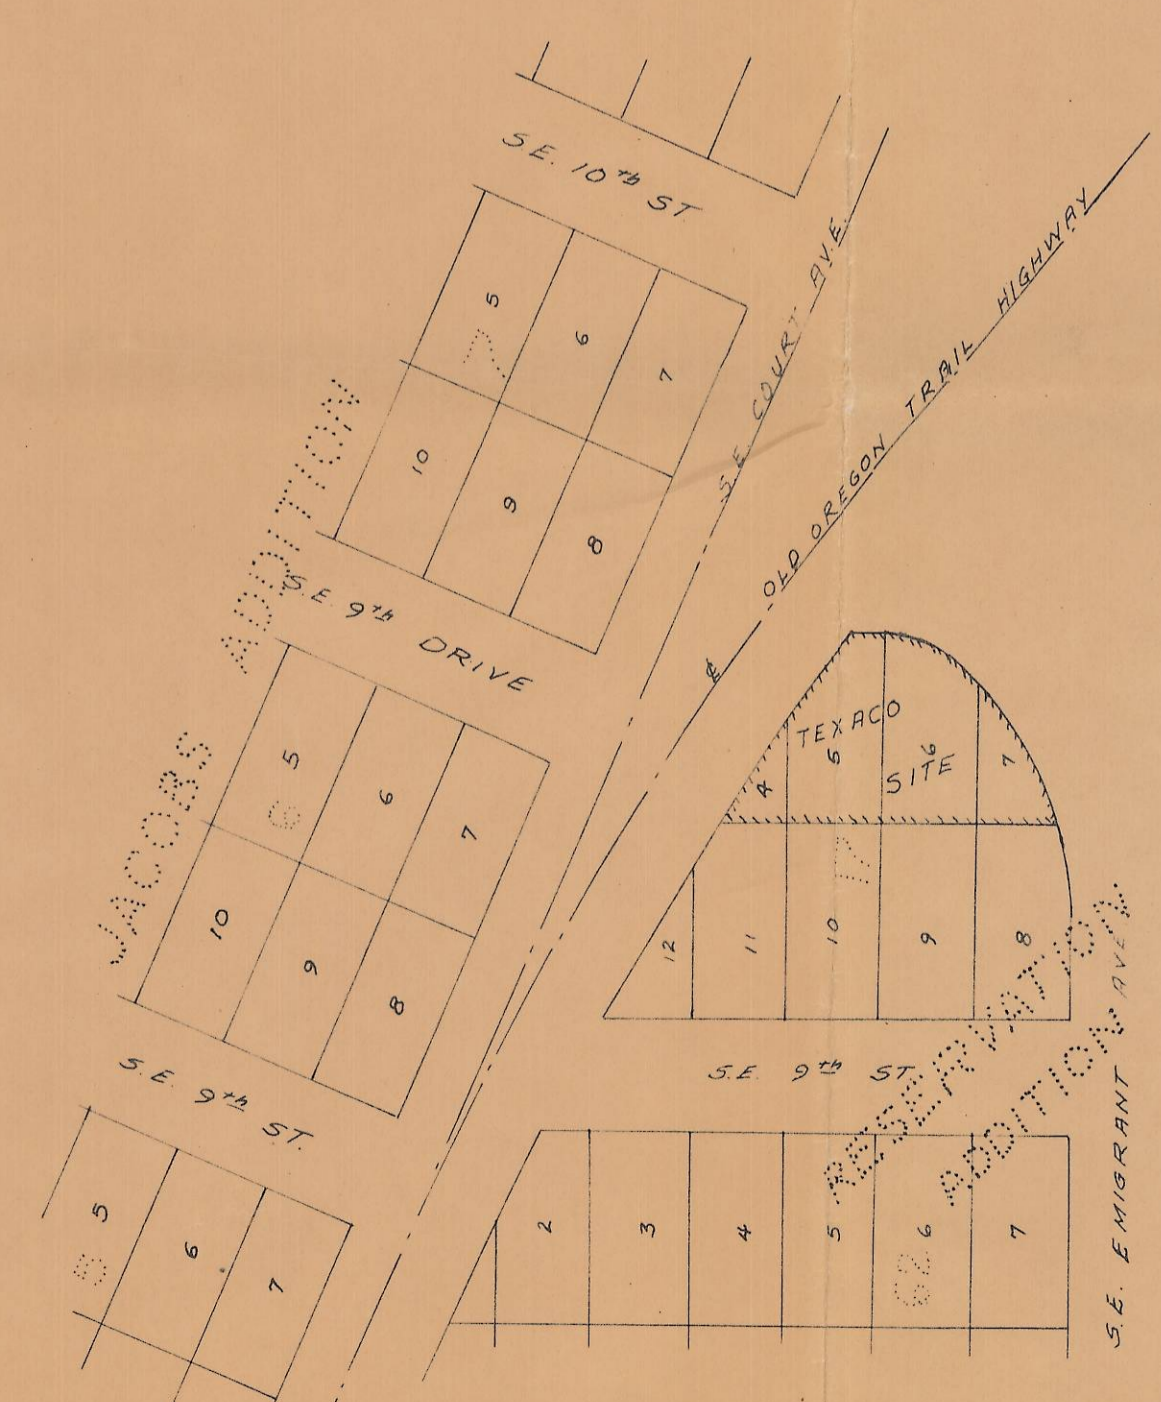


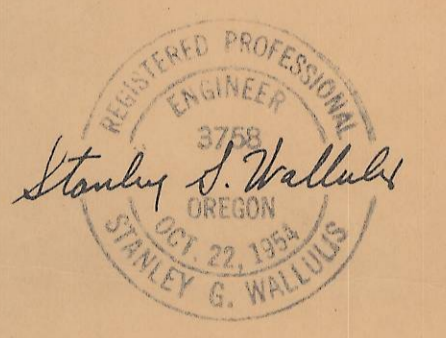

**SURVEY FOR HARRAH'S TEXACO STATION**

SCALE: 1"=10'      DATE: 12-5-60

STANLEY G. WALLULIS  
CONSULTING ENGINEER  
P.O. Box 91 Resurrection Add  
PENDLETON, OREGON 974

Q-346-C