

OREGON CORNER RESTORATION FORM

COUNTY: Umatilla. DATE: 03/19/20.

CORNER DESIGNATION: A-11, The North One-Quarter corner of Section 4, Township 1 North, Range 31 East, W.M.

PREVIOUS RENEWALS/SURVEYS ETC: Corner was originally established by Josiah A. Burnett under Contract No. 92 dated September 12, 1860. Notes state: Set post for 1/4 Sec. Cor., drove charred stake and raised mound with trench as per instructions.

MONUMENT AND ACCESSORIES FOUND: Found a scattered mound of large stones in a North-South fence line with remains of a old down fence, (stones and wire) extending West about 40 feet to the East edge of a CRP field. There is evidence of a berm from previous fencing extending East. I searched, but found no marked stone.

MONUMENT MARKING DETAIL:

T2N R31E
S33
1/4 -----
S4
T1N
2020
54657PLS

MONUMENT SET: At the intersection of the fence and scattered stone mound, set a 2 1/2" brass cap on 1 1/4 by 30" galvanized iron pipe 28" in the ground and surrounded with a 2 1/2' stone collar. Brass cap is marked as shown in Monument Marking Detail. Nailed a Witness sign to wood fence post 5' North of corner.

New accessories:

A 5/8 by 18" rebar with blue plastic cap marked "Wells Surveying 54657PLS" bears N 00°11' W, 44.8'.
A 5/8 by 18" rebar with blue plastic cap marked "Wells Surveying 54657PLS" bears N 00°07' E, 20.3'.
A 5/8 by 18" rebar with blue plastic cap marked "Wells Surveying 54657PLS" bears S 00°51' E, 11.8'.
A 5/8 by 18" rebar with blue plastic cap marked "Wells Surveying 54657PLS" bears S 00°26' E, 25.3'.
Rebar accessories are in a North-South fence line. Attached bearing object signs to the rebar accessories. Bearings to corner accessories are State Plane Grid bearings.


LOCATION AND COMMENTS: Corner falls on a steep East facing hillside about 50' East of the East edge of a CRP field.

OREGON STATE PLANE COORDINATE, North Zone NAD 83(91), International Feet Units:

N: 709644.07
E: 8600513.87

FIRM: Wells Surveying
P.O. Box 1696
Pendleton, OR 97801

Surveyor's Seal

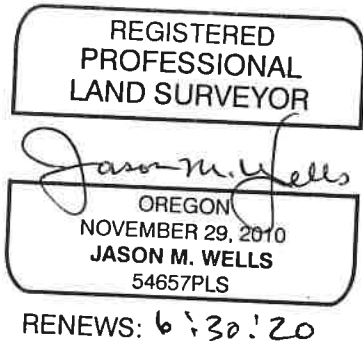

\1N31A-11

20-043-C