

**OREGON CORNER RESTORATION FORM**

COUNTY: Umatilla. DATE: 04/03/20

CORNER DESIGNATION: E-9, The Northeast corner of Section 8, Township 1 North, Range 31 East, W.M.

PREVIOUS RENEWALS/SURVEYS ETC: Corner was originally established by Josiah A. Burnett under Contract No. 92 dated September 12, 1860. Notes state: Set post for corner to Sec.'s 4, 5, 8 and 9., drove charred stake and raised mound with trench as per instructions. Willard Bradley, in Survey No. 411 in April 1916, reestablished this corner and set a stone of unstated dimensions. Record for Survey No. 411 is found in the Record of Private Survey Books.

MONUMENT AND ACCESSORIES FOUND: Found and accepted 18 by 14 by 10" stone marked "X" on top in a old East-West fence line. The stone loose and only set about 2" in dirt to the bedrock.

**MONUMENT MARKING DETAIL:**

T1N R31E  
S5|S4  
-----  
S8|S9  
2020  
54657PLS

MONUMENT SET: I shift the corner stone North and in it's place set a 5/8 by 18" rebar in hole drilled in rock and capped with a 2" aluminum cap marked as shown in Monument Marking Detail. The rebar monument is surrounded with a mound of stone. Nailed a Witness sign to a wood fence post in the existing fence line, 3' West of the corner.

**New accessories:**

- A 5/8 by 15" rebar with blue plastic cap marked "Wells Surveying 54657PLS" bears N 44°55' E, 31.2'.
  - A 5/8 by 15" rebar with blue plastic cap marked "Wells Surveying 54657PLS" bears S 40°30' E, 28.3'.
  - A 5/8 by 15" rebar with blue plastic cap marked "Wells Surveying 54657PLS" bears S 25°26' W, 32.4'.
  - A 5/8 by 15" rebar with blue plastic cap marked "Wells Surveying 54657PLS" bears N 31°25' W, 26.6'.
- Wired bearing object signs to the rebar accessories.  
Bearings to accessories are State Plane Grid bearings.

LOCATION AND COMMENTS: Corner falls on top of a ridge in a old East-West fence line. The corner area is very rocky. See notes on corner certificate G-9 regarding the 1/16 th corner stone found South of this corner.


**OREGON STATE PLANE COORDINATE, North Zone NAD 83(91), International Feet Units:**

N: 704126.16  
E: 8598032.44

FIRM: Wells Surveying  
P.O. Box 1696  
Pendleton, OR 97801

Surveyor's Seal

\1N31E-9

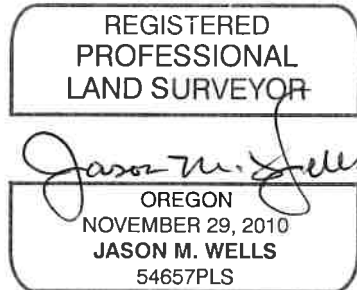

RENEWS: 6/30/20