

**OREGON CORNER RESTORATION FORM**

Section 18 Township 1N Range 32E  
 County Umatilla Date: September 8, 2009

Corner Designation: 1N32N1

Corner to sections 13 and 24, T1N, R31E, and sections 18 and 19, T1N, R32E, W.M., Umatilla County, Oregon.



Condition Report Only  
 Not found  
 Remonumented  
 Unrecorded  
 Surveyed in  
 Referenced out

Previous Renewals / Surveys, etc.

Corner originally set by Josiah A. Burnett under contract No. 92 dated September 12, 1860. His record reads: Set post for corner to secs. 13, 24, 18, and 19. Drove charred stake and raised mound with trench as per instructions.

Monument and accessories found. (condition and source)

None. The corner falls at the intersection of roads North, South and East.

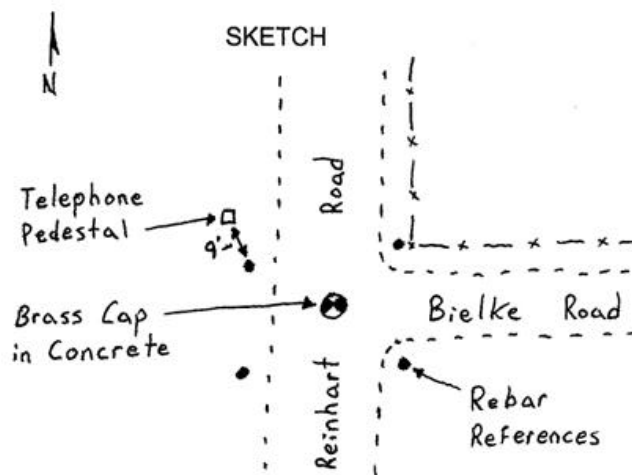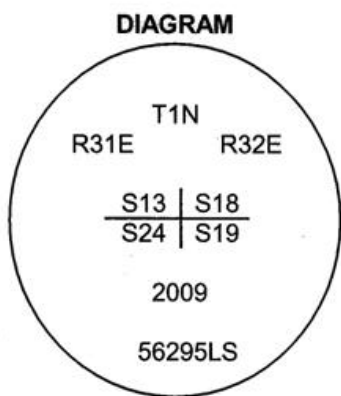

**MONUMENT (S) AND ACCESSORIES SET (Procedures and Description)**

At the intersection of Reinhart and Bielke roads I set a 5/8"x24" iron rebar 14" into the bedrock. Over this I cemented a 1 1/2" x 15" galvanized iron pipe with a 2 1/2" brass cap stamped as shown in the diagram above and poured a 12" ring of concrete around the monument. The cap is 8" below the surface of the road.

For references, I set four, 5/8" by 24" iron rebars with 1 1/4" orange plastic caps stamped WTS and 56295LS as described below:

- an iron rebar bears N40°29'25"W, 23.89 feet;
- an iron rebar bears N43°36'40"E, 41.76 feet;
- an iron rebar bears S54°50'09"E, 37.22 feet;
- an iron rebar bears S43°48'54"W, 24.60 feet;

The monument and references were tied using a Trimble R7/R8 RTK GPS system.

Location and comments  
 NAD 83/1991 State Plane Coordinate  
 Oregon North Zone  
 N = 694,057.65 ift  
 E = 8,619,224.72 ift

Compass Declination  
 Firm / Agency  
 Witness Tree Surveying  
 Address  
 P.O. Box G  
 Pilot Rock, Or. 97868  
 Party Chief  
 Stephen K, Haddock

Surveyors Seal

RECEIVED BY:  
 Umatilla County Surveyor  
 Date: 6-10  
 Rec'd By: KK  
 No. 10-93-c

REGISTERED  
 PROFESSIONAL  
 LAND SURVEYOR

*Stephen K. Haddock*

OREGON  
 JULY 9, 2001  
 STEPHEN K. HADDOCK  
 56295LS

RENEWAL DATE 6-30-11