

OREGON CORNER RESTORATION FORM


Section 19 Township 1N Range 32E
 County Umatilla Date: September 8, 2009

Corner Designation: 1N32R1
 Corner to sections 24 and 25, T1N, R31E, and sections 19 and 30, T1N, R32E, W.M., Umatilla County, Oregon.

Condition Report Only
 Not found
 Remonumented
 Unrecorded
 Surveyed in
 Referenced out

Previous Renewals / Surveys, etc.
 Corner originally set by Josiah A. Burnett under contract No. 92 dated September 12, 1860. His record reads: Set corner to secs. 19, 30, 24, and 25. Drove charred stake and raised mound with trench as per instructions. In survey Q-52-Ax Geary Kimbrell says: Stone. In the survey for County Road No. 777, Willard Bradley says: Stone Monument.

Monument and accessories found. (condition and source)
 None. The corner falls in the center of an East-West road.

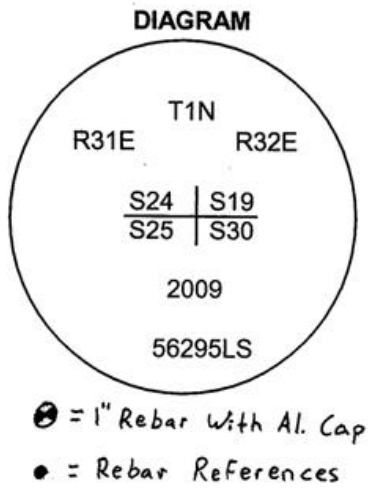

SKETCH

MONUMENT (S) AND ACCESSORIES SET (Procedures and Description)
 At the intersection of the centerline of the East - West road and a plow berm running south I set a 1"x24" iron rebar with a 2" aluminum cap stamped as shown above 15" into the bedrock. The cap is 7" below the surface of the road.

For references, I set four, 5/8" by 24" iron rebars with 1 1/4" orange plastic caps stamped WTS and 56295LS as described below:
 an iron rebar bears N51°55'19"W, 30.00 feet;
 an iron rebar bears N56°01'53"E, 32.89 feet;
 an iron rebar bears S43°59'01"E, 33.99 feet;
 an iron rebar bears S44°07'09"W, 35.27 feet;

The monument and references were tied using a Trimble R7/R8 RTK GPS system.

Location and comments
 NAD 83/1991 State Plane Coordinate
 Oregon North Zone
 N = 688,765.52 ift
 E = 8,619,299.00 ift

Compass Declination
 Firm / Agency
 Witness Tree Surveying
 Address
 P.O. Box G
 Pilot Rock, Or. 97868
 Party Chief
 Stephen K, Haddock

Surveyors Seal

RECEIVED BY:
 Umatilla County Surveyor
 Date: 6-10
 Rec'd By: KK
 No. 10-93-C

REGISTERED PROFESSIONAL LAND SURVEYOR
Stephen K. Haddock
OREGON
 JULY 9, 2001
STEPHEN K. HADDOCK
 56295LS
 RENEWAL DATE 6-30-11