

OREGON CORNER RESTORATION FORM

Section 4 Township 1N Range 32E
 County Umatilla Date: August 31, 2009

Corner Designation: 1N32E11

Condition Report Only

- Not found
- Remonumented
- Unrecorded
- Surveyed in
- Referenced out


Quarter corner common to sections 4 and 9, T1N, R32E, W.M., Umatilla County, Oregon.

Previous Renewals / Surveys, etc.

Corner originally set by Daniel Chaplin under contract No. 107 dated September 21, 1864. His record reads: Set post for 1/4 sec. cor. in mound of earth with charred stake, pits &c as per instructions. L. E. Macomber in record of survey in Book 1 Page 439 stated: Set stone, dated October 19, 1900. G. Kimbrell in record of survey in Book 2 Page 239 stated: Set post, dated October 29, 1913.


Monument and Accessories found: (condition and source)

None. The area had been excavated with a backhoe for fence construction.

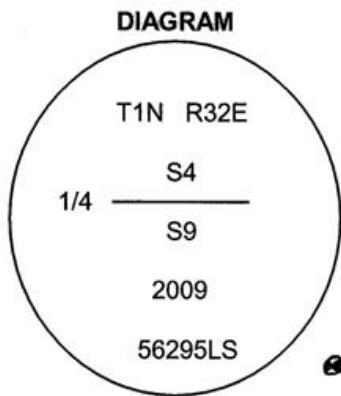

⊙ = Brass Cap
 ● = Rebar Reference

SKETCH

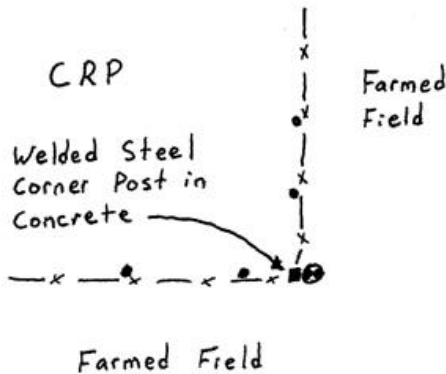

MONUMENT (S) AND ACCESSORIES SET (Procedures and Description)

At the intersection of fences running West and North I set a 2 1/2" brass cap on a 1 1/2" x 30" galvanized iron pipe flush with the surface of the ground. The cap was stamped as shown in the diagram above.

For references, I set four 5/8" by 24" iron rebars with 1 1/4" orange plastic caps stamped WTS and 56295LS as described below:

- an iron rebar bears N01°18'29"E, 74.00 feet under the existing fence;
- an iron rebar bears N01°10'41"E, 38.06 feet under the existing fence;
- an iron rebar bears S89°18'45"W, 35.11 feet under the existing fence;
- an iron rebar bears S89°21'40"W, 76.65 feet under the existing fence;

The monument and references were tied using a Trimble R7/R8 RTK GPS system.

Location and comments
 NAD 83/1991 State Plane Coordinate
 Oregon North Zone
 N = 704,801.59 ift
 E = 8,632,767.17 ift

Compass Declination

Surveyors Seal

RECEIVED BY:
 Umatilla County Surveyor
 Date: 6-10
 Rec'd By: KE
 No. 10-93-0

Firm / Agency
 Witness Tree Surveying
 Address
 P.O. Box G
 Pilot Rock, Or. 97868
 Party Chief
 Stephen K, Haddock

REGISTERED
 PROFESSIONAL
 LAND SURVEYOR

Stephen K. Haddock

OREGON
 JULY 9, 2001
 STEPHEN K. HADDOCK
 56295LS

RENEWAL DATE 6-30-11