

OREGON CORNER RESTORATION FORM



Section 4 Township 1N Range 32E
 County Umatilla Date: September 7, 2009

Corner Designation: 1N32E13
 Corner common to sections 3, 4, 9, and 10, T1N, R32E,
 W.M., Umatilla County, Oregon.

Condition Report Only
 Not found
 Remonumented
 Unrecorded
 Surveyed in
 Referenced out

Previous Renewals / Surveys, etc.
 This corner was originally set by Daniel Chaplin under contract No. 107 dated September 21, 1864. His record reads: Set post for corner to secs. 3, 4, 9 and 10 in mound of earth with charred stake, pits &c as per instructions. L. E. Macomber in record of survey in Book 1, Page 439 stated: Set stone, dated October 19, 1900. G. Kimbrell in record of survey in Book 2, Page 239 stated: Set stone 18 x 6 x 7, dated October 29, 1913.

Monument and Accessories found: (condition and source)
 None. The point falls in a farmed field.

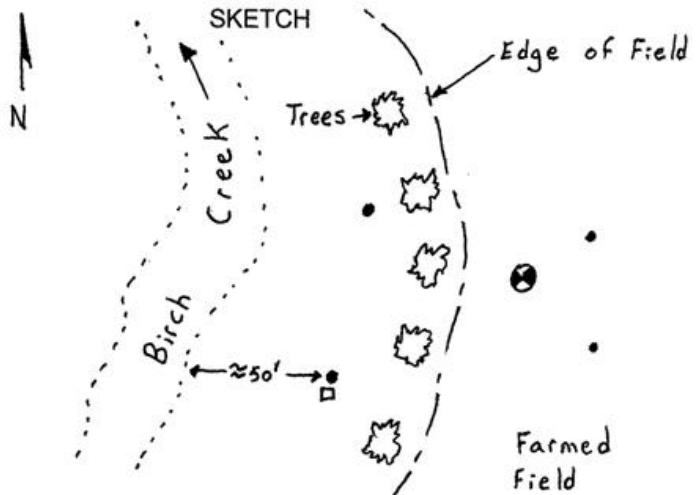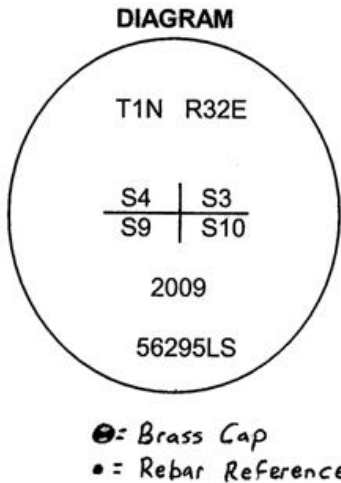

MONUMENT (S) AND ACCESSORIES SET (Procedures and Description)

At the corner point calculated using Kimbrell's record of survey, I set a 2 1/2" brass cap on a 1 1/2" x 30" galvanized iron pipe 22" below the surface of the farmed field. The cap was stamped as shown in the diagram above.

For references, I set four, 5/8" by 24" iron rebars with 1 1/4" orange plastic caps stamped WTS and 56295LS as described below:
 an iron rebar bears N80°37'11"W, 77.72 feet 6" below the surface;
 an iron rebar bears N50°00'11"E, 25.60 feet 2 feet below the surface of the field;
 an iron rebar bears S40°07'17"E, 26.61 feet 2 feet below the surface of the field;
 an iron rebar bears S66°37'30"W, 86.07 feet 6" below the surface with a 6' steel guard post with a Bearing Object sign along side.

The monument was set and references were tied using a Trimble R7/R8 RTK GPS system.

Location and comments
 NAD 83/1991 State Plane Coordinate
 Oregon North Zone
 N = 704,860.43 ift
 E = 8,635,392.11 ift

Compass Declination
 Firm / Agency
 Witness Tree Surveying
 Address
 P.O. Box G
 Pilot Rock, Or. 97868
 Party Chief
 Stephen K, Haddock

Surveyors Seal

RECEIVED BY:
 Umatilla County Surveyor
 Date: 6-10
 Rec'd By: KE
 No. 10-98-C

REGISTERED
 PROFESSIONAL
 LAND SURVEYOR

Stephen K. Haddock

OREGON
 JULY 9, 2001
 STEPHEN K. HADDOCK
 56295LS

RENEWAL DATE 6-30-11