

OREGON CORNER RESTORATION FORM

Section 12 Township 1N Range 32E
 County Umatilla Date: July 15, 2009

Corner Designation: 1N32J23

Quarter corner common to sections 12 and 13,
 T1N, R32E, W.M., Umatilla County, Oregon.



Previous Renewals / Surveys, etc.

Corner originally set by Daniel Chaplin under contract No. 107 dated September 21, 1864.
 His record reads: Set post for 1/4 sec. cor. in mound of earth with charred stake, pits &c as per instructions. Zenas F. Moody under contract No. 164 dated October 4, 1871, stated: Set stone, 18 x 12 x 7.

Condition Report Only
 Not found
 Remonumented
 Unrecorded
 Surveyed in
 Referenced out

Monument and Accessories found: (condition and source)

The east-west county road can still be located and there is a fence running south from the corner point.

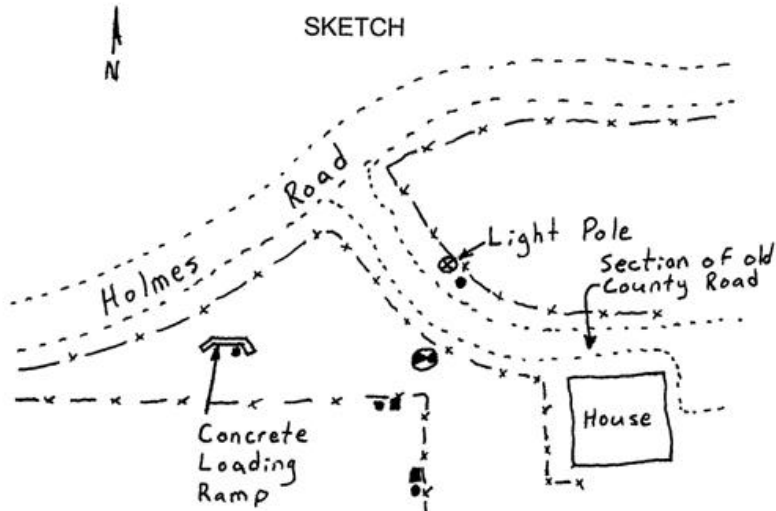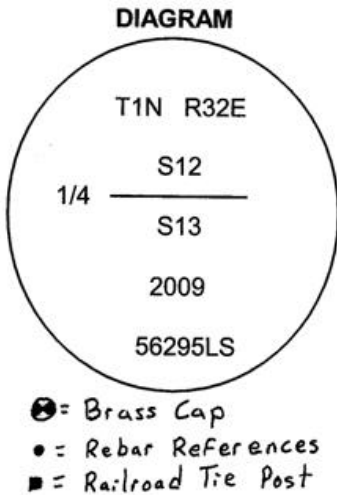

MONUMENT (S) AND ACCESSORIES SET (Procedures and Description)

At the intersection of the fence running south and the east - west section line, (this line is coincident with the center of the old county road) I set a 1 1/2"x30" galvanized iron pipe with a 2 1/2" brass cap stamped as shown in the diagram above. The cap is 18" below the surface of a horse pasture that is plowed periodically.

For references, I set four 5/8" by 24" iron rebars with 1 1/4" orange plastic caps stamped WTS and 56295LS as described below:

- an iron rebar bears N79°59'18"W, 224.03 feet on the inside corner of a concrete loading ramp;
- an iron rebar bears N30°20'43"E, 45.58 feet;
- an iron rebar bears S33°12'46"W, 36.20 feet under the existing fence running west;
- an iron rebar bears S00°06'08"E, 90.28 feet under the existing fence running south;

The monument was set and references tied using a Trimble R7/R8 RTK GPS system.

Location and comments
 NAD 83/1991 State Plane Coordinate
 Oregon North Zone
 N = 699,804.16 ft
 E = 8,648,652.52 ft

Compass Declination

Surveyors Seal

RECEIVED BY:
Umatilla County Surveyor
 Date: 6-10
 Rec'd By: KK
 No. 18-63-C

Firm / Agency
 Witness Tree Surveying
 Address
 P.O. Box G
 Pilot Rock, Or. 97868
 Party Chief
 Stephen K, Haddock

REGISTERED
 PROFESSIONAL
 LAND SURVEYOR

Stephen K. Haddock

OREGON
 JULY 9, 2001
 STEPHEN K. HADDOCK
 56295LS

RENEWAL DATE 6-30-11