

OREGON CORNER RESTORATION FORM

Section 13 Township 1N Range 32E
 County Umatilla Date: June 29, 2009

Corner Designation: 1N32N21

Corner common to sections 13, 14, 23, and 24,
 T1N, R32E, W.M., Umatilla County, Oregon.



Condition Report Only
 Not found
 Remonumented
 Unrecorded
 Surveyed in
 Referenced out

Previous Renewals / Surveys, etc.

Corner was originally set by Daniel Chaplin under contract No. 107, dated September 21, 1864. His record reads: Set post for corner to secs. 13, 14, 23 and 24 in mound of earth with charred stake, pits &c as per instructions. Zenas F. Moody under contract No. 164, dated October 4, 1871, stated: Set post. Currin and Noland under special contract dated May 4, 1887, stated: Set stone, 10 x 8 x 8 ins. In record of survey H-255-B, set rock 7 x 7 x 12. Wayne Harris, in his unrecorded survey for Dan Shaw set a 5/8" iron rebar. David H. Krumbein in record of survey 90-20-B states: found 5/8" iron pin. Stephen K. Haddock in record of survey 02-161-B states: Found 5/8" rebar.

Monument and Accessories found: (condition and source)

The 5/8" iron rebar reported in 90-20-B slightly bent from road grading.

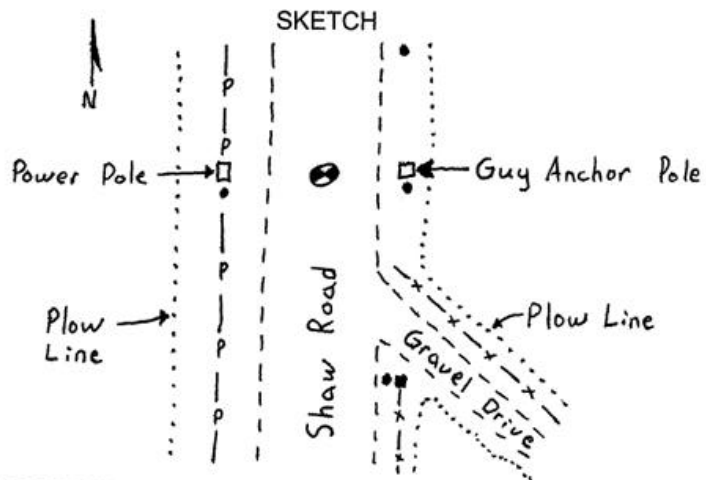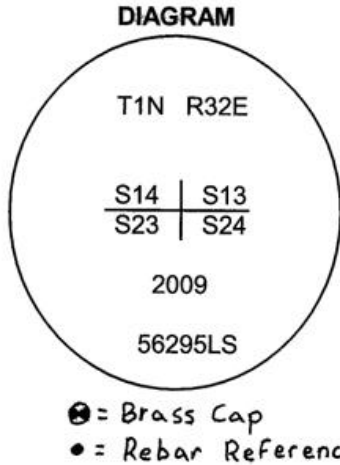

MONUMENT (S) AND ACCESSORIES SET (Procedures and Description)

At the position of the rebar I set a 1 1/2" x 30" galvanized iron pipe with a 2 1/2" brass cap stamped as shown in the diagram above. The cap is 6" below the surface of the road.

For references, I set four, 5/8" by 24" iron rebars with 1 1/4" orange plastic caps stamped WTS and 56295LS as described below:

- an iron rebar bears N26°04'46"E, 49.81 feet, 2 feet below the surface ;
- an iron rebar bears S82°56'17"E, 21.96 feet;
- an iron rebar bears S18°51'45"E, 89.88 feet;
- an iron rebar bears S84°04'23"W, 26.31 feet;

The monument and references were tied using a Trimble R7/R8 RTK GPS system.

Location and comments
 NAD 83/1991 State Plane Coordinate
 Oregon North Zone
 N = 694,538.73 ift
 E = 8,646,149.72 ift

Compass Declination

Firm / Agency
 Witness Tree Surveying
 Address
 P.O. Box G
 Pilot Rock, Or. 97868
 Party Chief
 Stephen K. Haddock

Surveyors Seal

RECEIVED BY:
 Umatilla County Surveyor
 Date: 6-10
 Rec'd By: KL
 No. 10-93-C

REGISTERED
 PROFESSIONAL
 LAND SURVEYOR

Stephen K. Haddock

OREGON
 JULY 9, 2001
 STEPHEN K. HADDOCK
 56295LS

RENEWAL DATE 6-30-11