

OREGON CORNER RESTORATION FORM

Section 23 Township 1N Range 32E
 County Umatilla Date: June 29, 2009

Corner Designation: 1N32R21

Corner common to sections 23, 24, 25, and 26,
 T1N, R32E, W.M., Umatilla County, Oregon.


Condition Report Only
 Not found
 Remonumented
 Unrecorded
 Surveyed in
 Referenced out

Previous Renewals / Surveys, etc.

Corner originally set by Daniel Chaplin under contract No. 107 dated September 21, 1864. His record reads: Set stone 18x10x8 for corner to secs. 23, 24, 25, and 26. Zenas Moody set a new corner under contract No. 164 dated October 4, 1871. His record reads: Set stone 20x18x14 for corner to sections 25, 26, 23 and 24. Currin and Noland, under special instructions dated May 4th, 1887 re-established the corner. Their record reads: To old corner. Reestablished corner. Set stone, 16x10x8 ins., 12 ins. in the ground for 1/4 sec. cor. marked 1/4 on W. face. Dug pits, 18 x 18 x 12 ins., N. and S. from stone, 5 1/2 ft. dist. and raised a mound of earth 1 1/2 ft. high, 3 1/2 ft. base alongside. In survey 02-161-B I set a 1"x24" iron rebar with a 2" aluminum cap stamped as shown in the diagram below. In survey 04-182-B, Dave Krumbein reports finding a bent iron rebar at this corner.

Monument and Accessories found: (condition and source)
 I found the aluminum cap and rebar from my survey 02-161-B in good condition. The reported iron rebar from survey 04-182-B is at a corner another mile to the north.

DIAGRAM

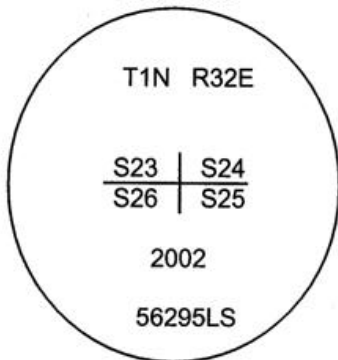

SKETCH

MONUMENT (S) AND ACCESSORIES SET (Procedures and Description)

None. I held the monument from survey 02-161-B. This certificate is being filed to report the state plane coordinates of the corner as given below.

For references:

The monument was tied using a Trimble R7/R8 RTK GPS system.

Location and comments
 NAD 83/1991 State Plane Coordinate
 Oregon North Zone
 N = 689,198.06 ift
 E = 8,646,211.05 ift

Compass Declination

Surveyors Seal

RECEIVED BY:
Umatilla County Surveyor
 Date: 6-10
 Rec'd By: KK
 No. 10-93-e

Firm / Agency
 Witness Tree Surveying
 Address
 P.O. Box G
 Pilot Rock, Or. 97868
 Party Chief
 Stephen K, Haddock

REGISTERED
 PROFESSIONAL
 LAND SURVEYOR

Stephen K. Haddock

OREGON
 JULY 9, 2001
 STEPHEN K. HADDOCK
 56295LS

RENEWAL DATE 6-30-11