

OREGON CORNER RESTORATION FORM

Section 19 Township 1N Range 32E
 County Umatilla Date: September 7, 2009

Corner Designation: 1N32R3


Quarter corner common to sections 19 and 30,
 T1N, R32E, W.M., Umatilla County, Oregon.

Condition Report Only
 Not found
 Remonumented
 Unrecorded
 Surveyed in
 Referenced out


Previous Renewals / Surveys, etc.

Corner originally set by Daniel Chaplin under contract No. 107 dated September 21, 1864.
 His record reads: Set stone 24 x 14 x 12, for 1/4 sec. corner. J. Kimbrell in record of survey in
 Book 1, Page 525 states: Set stone 20 x 10 x 8.

Monument and Accessories found: (condition and source)
 I found the original basalt stone by Chaplin, 23x12x12 ins., in place at the west edge of a plowed
 field.

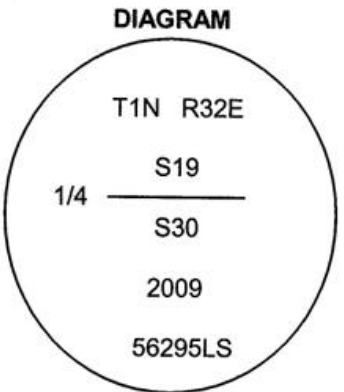

- ⊙ = Brass Cap
- = Rebar References
- = Steel Guard Post

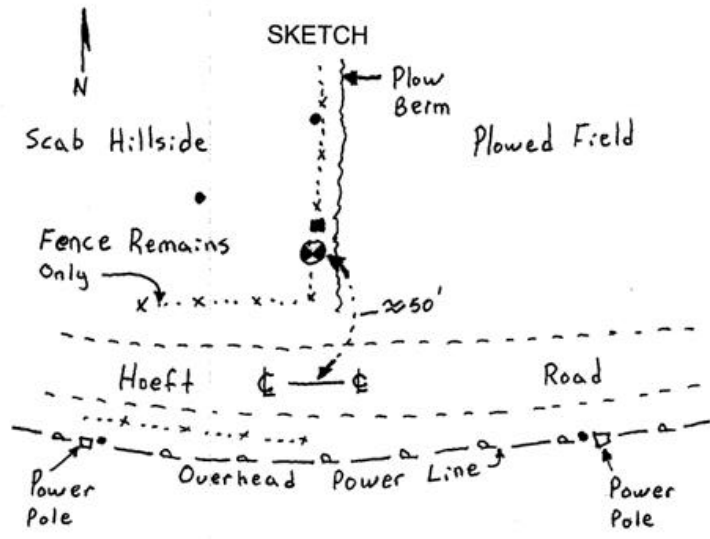

MONUMENT (S) AND ACCESSORIES SET (Procedures and Description)
 At the position of the original stone I drove a 5/8"x24" iron rebar 10 inches into the bedrock and cemented a 1 1/2"x14" galvanized iron pipe with a 2 1/2" brass cap onto the rebar. The cap is flush with the ground and stamped as shown above. I buried the original stone along side. I drove a 6' steel guard post with a monument sign on the north side of the cap.

For references, I set four 5/8" by 24" iron rebars with 1 1/4" orange plastic caps stamped WTS and 56295LS as described below:
 an iron rebar bears N54°57'28"W, 126.16 feet;
 an iron rebar bears N03°17'19"W, 40.19 feet;
 an iron rebar bears S71°46'37"E, 205.97 feet on the west side of a power pole;
 an iron rebar bears S70°28'31"W, 192.65 feet on the east side of a power pole;

The monument and references were tied using a Trimble R7/R8 RTK GPS system.

Location and comments
 NAD 83/1991 State Plane Coordinate
 Oregon North Zone
 N = 688,794.68 ift
 E = 8,622,486.19 ift

Compass Declination
 Firm / Agency
 Witness Tree Surveying
 Address
 P.O. Box G
 Pilot Rock, Or. 97868
 Party Chief
 Stephen K, Haddock

Surveyors Seal

RECEIVED BY:
Umatilla County Surveyor
 Date: 6-10
 Rec'd By: KK
 No. 10-93-C

REGISTERED
 PROFESSIONAL
 LAND SURVEYOR

Stephen K. Haddock

OREGON
 JULY 9, 2001
 STEPHEN K. HADDOCK
 56295LS

RENEWAL DATE 6-30-11