

OREGON CORNER RESTORATION FORM

Section 28 Township 1N Range 32E
 County Umatilla Date: September 14, 2009

Corner Designation: 1N32T13

Quarter corner common to sections 27 and 28,
 T1N, R32E, W.M., Umatilla County, Oregon.


Condition Report Only
 Not found

Remonumented
 Unrecorded
 Surveyed in
 Referenced out


Previous Renewals / Surveys, etc.

Corner originally set by Daniel Chaplin under contract No. 107 Dated September 21, 1864.
 His record reads: Set stone, 15 x 8 x 5, for 1/4 sec. cor. J. Kimbrell in record of survey in Book 1,
 Page 488 states: Set stone 18 x 9 x 6.

Monument and Accessories found: (condition and source)
 None. The point falls in a plowed field.

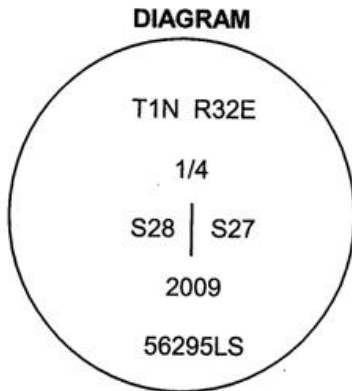

- ⊗ = Brass Cap
- = Rebar Reference
- = Steel Guard Post

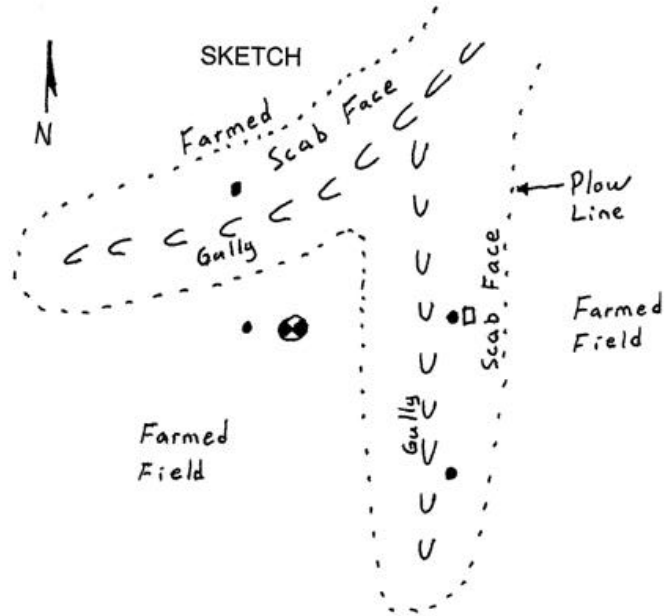

MONUMENT (S) AND ACCESSORIES SET (Procedures and Description)

I set a 1 1/2" x 30" galvanized iron pipe with a 2 1/2" brass cap stamped as shown in the diagram above at the fence intersection.

For references, I set four 5/8" by 24" iron rebars with 1 1/4" orange plastic caps stamped WTS and 56295LS as described below:

- an iron rebar bears N37°07'33"W, 203.58 feet;
- an iron rebar bears S89°46'55"E, 121.35 feet;
- an iron rebar bears S42°17'09"E, 229.62 feet;
- an iron rebar bears S69°17'40"W, 31.29 feet, 2 feet below the surface of the field;

The monument was set and references tied using a Trimble R7/R8 RTK GPS system.

Location and comments
 NAD 83/1991 State Plane Coordinate
 Oregon North Zone
 N = 686,394.87 ft
 E = 8,635,729.60 ft

Compass Declination

Surveyors Seal

RECEIVED BY:
Umatilla County Surveyor
 Date: 10-10
 Rec'd By: [Signature]
 No. 10-93-C

Firm / Agency
 Witness Tree Surveying
 Address
 P.O. Box G
 Pilot Rock, OR 97868
 Party Chief
 Stephen K, Haddock

REGISTERED
 PROFESSIONAL
 LAND SURVEYOR

Stephen K. Haddock

OREGON
 JULY 9, 2001
 STEPHEN K. HADDOCK
 56295LS

RENEWAL DATE 6-30-11