

OREGON CORNER RESTORATION FORM

Section 25 Township 1N Range 32E
 County Umatilla Date: June 30, 2009

Corner Designation: 1N32T21

Quarter corner common to sections 25 and 26,
 T1N, R32E, W.M., Umatilla County, Oregon.


Condition Report Only
 Not found
 Remonumented
 Unrecorded
 Surveyed in
 Referenced out

Previous Renewals / Surveys, etc.

Corner originally set by Daniel Chaplin under contract No. 107 Dated September 21, 1864.
 His record reads: Set post for 1/4 section corner in mound of earth with charred stake,
 pits, etc., as per instructions. Zenas F. Moody under contract No. 164 dated October 4, 1871
 states: Set post. Currin and Noland under special contract dated May 4, 1887 state: Set stone
 8 x 10 x 16 ins. David H. Krumbein in record of survey 04-182-B states: Found nail at road,
 set brass cap.

Monument and Accessories found: (condition and source)

I found the nail reported by Krumbein. The brass cap and references had not been set.

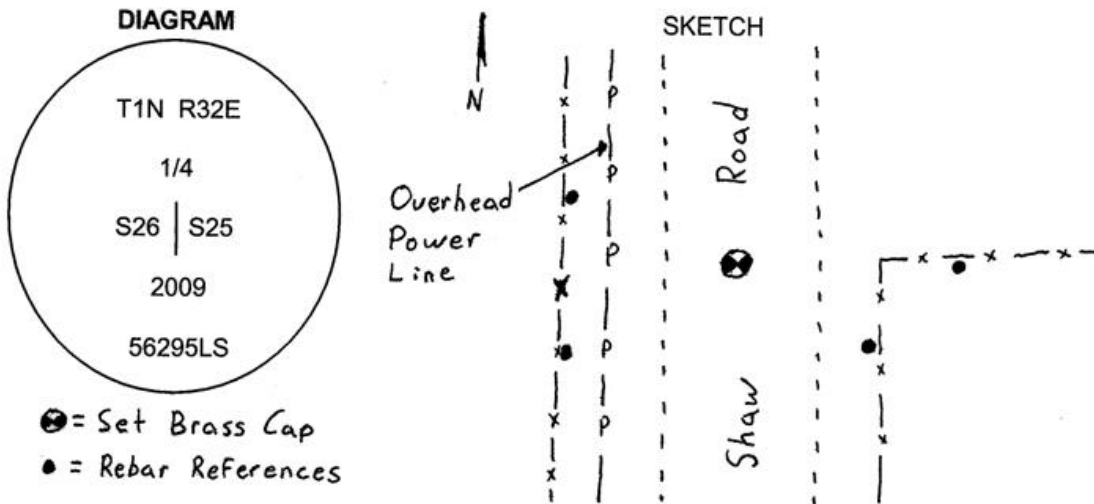

MONUMENT (S) AND ACCESSORIES SET (Procedures and Description)

I set a 1 1/2" x 30" galvanized iron pipe with a 2 1/2" brass cap stamped as shown in the diagram above at the position of the nail.

For references, I set four 5/8" by 24" iron rebars with 1 1/4" orange plastic caps stamped WTS and 56295LS as described below:

- an iron rebar bears N28°57'09"W, 54.49 feet under the existing fence;
- an iron rebar bears S89°32'37"E, 32.04 feet under the existing fence;
- an iron rebar bears S41°25'13"E, 29.11 feet under the existing fence;
- an iron rebar bears S25°19'07"W, 56.72 feet under the existing fence;

The monument and references tied using a Trimble R7/R8 RTK GPS system.

Location and comments
 NAD 83/1991 State Plane Coordinate
 Oregon North Zone
 N = 686,555.25 ift
 E = 8,646,252.05 ift

Compass Declination

Surveyors Seal

RECEIVED BY:
Umatilla County Surveyor
 Date: 6-10
 Rec'd By: KK
 No. 10-93-C

Firm / Agency
 Witness Tree Surveying
 Address
 P.O. Box G
 Pilot Rock, OR 97868
 Party Chief
 Stephen K, Haddock

REGISTERED
 PROFESSIONAL
 LAND SURVEYOR

Stephen K. Haddock

OREGON
 JULY 9, 2001
 STEPHEN K. HADDOCK
 56295LS

RENEWAL DATE 6-30-11