

OREGON CORNER RESTORATION FORM

Section 28 Township 1N Range 32E
 County Umatilla Date: September 14, 2009

Corner Designation: 1N32V11

Condition Report Only
 Not found

Quarter corner common to sections 28 and 33,
 T1N, R32E. W.M., Umatilla County, Oregon.

Remonumented
 Unrecorded
 Surveyed in
 Referenced out


Previous Renewals / Surveys, etc.

Corner originally set by Daniel Chaplin under contract No. 107 dated September 21, 1864.
 His record reads: Set post for 1/4 sec. corner in mound of earth with charred stake, pits &
 as per instructions.

Monument and Accessories found: (condition and source)
 None. The point falls in a plowed field.

DIAGRAM

SKETCH

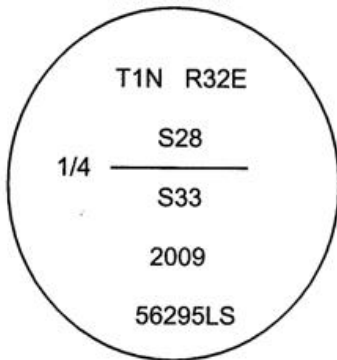

MONUMENT (S) AND ACCESSORIES SET (Procedures and Description)

At the proportionate point I set a 1 1/2"x30" galvanized iron pipe with a 2 1/2" brass cap stamped as shown in the diagram above. The cap is 24 inches below the surface of the field.

For references, I set four 5/8" by 24" iron rebars with 1 1/4" orange plastic caps stamped WTS and 56295LS as described below:

- an iron rebar bears N02°24'17"W, 27.06 feet, 2 feet below the surface;
- an iron rebar bears S82°09'45"E, 34.89 feet, 2 feet below the surface;
- an iron rebar bears S01°57'50"E, 41.52 feet, 2 feet below the surface;
- an iron rebar bears S79°15'37"W, 36.22 feet, 2 feet below the surface;

The monument and references were tied using a Trimble R7/R8 RTK GPS system.

Location and comments
 NAD 83/1991 State Plane Coordinate
 Oregon North Zone
 N = 683,715.79 ft
 E = 8,633,153.40 ft

Compass Declination

Surveyors Seal

RECEIVED BY:
Umatilla County Surveyor
 Date: 6-10
 Rec'd By: KK
 No. 10-93-C

Firm / Agency
 Witness Tree Surveying
 Address
 P.O. Box G
 Pilot Rock, Or. 97868
 Party Chief
 Stephen K, Haddock

REGISTERED
 PROFESSIONAL
 LAND SURVEYOR

Stephen K. Haddock

OREGON
 JULY 9, 2001
 STEPHEN K. HADDOCK
 56295LS

RENEWAL DATE 6-30-11