

OREGON CORNER RESTORATION FORM

Section 27 Township 1N Range 32E
County Umatilla Date: July 13, 2009

Corner Designation: 1N32V15

Condition Report Only
 Not found
 Remonumented
 Unrecorded
 Surveyed in
 Referenced out


Quarter corner common to sections 27 and 34,
T1N, R32E, W.M., Umatilla County, Oregon.

Previous Renewals / Surveys, etc.

Corner originally set by Daniel Chaplin under contract No. 107 dated September 21, 1864.
His record reads: Set stone, 15 x 8 x 8, for 1/4 sec. corner. J. Kimbrell in record of survey in
Book 1, Page 489 states: Set stone 16 x 8 x 7. David L. Haddock under survey 97-145-C states:
Set brass cap and four reference monuments.

Monument and Accessories found: (condition and source)
I found the brass cap by Haddock in good condition.

DIAGRAM

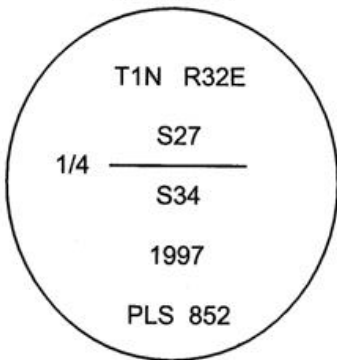

SKETCH

MONUMENT (S) AND ACCESSORIES SET (Procedures and Description)

None. I held the monument from 97-145-C. This certificate is being filed to report the state plane coordinates shown below.

For references:

The monument and references were tied using a Trimble R7/R8 RTK GPS system.

Location and comments
NAD 83/1991 State Plane Coordinate
Oregon North Zone
N = 683,800.12 ift
E = 8,638,440.22 ift

Compass Declination
Firm / Agency
Witness Tree Surveying
Address
P.O. Box G
Pilot Rock, Or. 97868
Party Chief
Stephen K, Haddock

Surveyors Seal

REGISTERED
PROFESSIONAL
LAND SURVEYOR

Stephen K. Haddock

OREGON
JULY 9, 2001
STEPHEN K. HADDOCK
56295LS

RENEWAL DATE 6-30-11

RECEIVED BY:
Umatilla County Surveyor
Date: 6-10
Rec'd By: LK
No. 10-93-C