

OREGON CORNER RESTORATION FORM

Section 29 Township 1N Range 32E
 County Umatilla Date: September 14, 2009

Corner Designation: 1N32V9



Corner common to sections 28, 29, 32, and 33,
 T1N, R32E, W.M., Umatilla County, Oregon.

Previous Renewals / Surveys, etc.

Corner was originally set by Daniel Chaplin under contract No. 107 dated September 21, 1864.
 His record reads: Set stone, 18 x 15 x 5, for corner to secs. 28, 29, 32 and 33.

Condition Report Only
 Not found
 Remonumented
 Unrecorded
 Surveyed in
 Referenced out

Monument and Accessories found: (condition and source)
 None. This point falls in a plowed field.

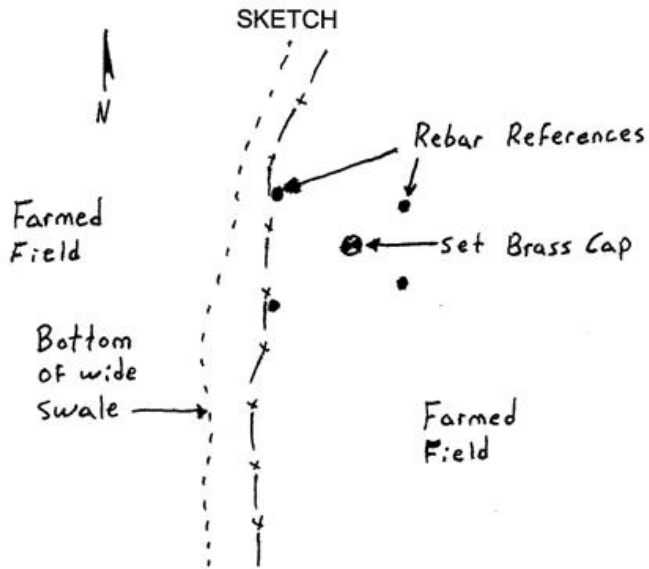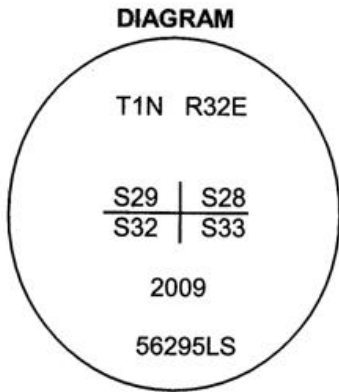

MONUMENT (S) AND ACCESSORIES SET (Procedures and Description)

At the proportionate position I set a 1 1/2" x 30" galvanized iron pipe with a 2 1/2" brass cap stamped as shown in the diagram above. The cap is 24" below the surface.

For references, I set four, 5/8" by 24" iron rebars with 1 1/4" orange plastic caps stamped WTS and 56295LS as described below:

- an iron rebar bears N22°45'04"W, 77.53 feet under the existing fence;
- an iron rebar bears N28°59'52"E, 32.60 feet, 2 feet below the surface;
- an iron rebar bears S23°21'39"E, 31.59 feet, 2 feet below the surface;
- an iron rebar bears S33°48'30"W, 47.44 feet under the existing fence;

The monument was set and references were tied using a Trimble R7/R8 RTK GPS system.

Location and comments
 NAD 83/1991 State Plane Coordinate
 Oregon North Zone
 N = 683,648.66 ift
 E = 8,630,515.47 ift

Compass Declination

Surveyors Seal

RECEIVED BY:
Umatilla County Surveyor
 Date: 6-10
 Rec'd By: KK
 No. 10-93-C

Firm / Agency
 Witness Tree Surveying
 Address
 P.O. Box G
 Pilot Rock, Or. 97868
 Party Chief
 Stephen K, Haddock

REGISTERED
 PROFESSIONAL
 LAND SURVEYOR

Stephen K. Haddock

OREGON
 JULY 9, 2001
 STEPHEN K. HADDOCK
 56295LS

RENEWAL DATE 6-30-11