

**OREGON CORNER RESTORATION FORM**

Section 34 Township 1N Range 32E  
 County Umatilla Date: July 25, 1997

Corner Designation: 1N32X13

Condition Report Only  
 Not found

1/4 corner to sections 33 and 34 T1N, R32E W.M.


Remonumented  
 Unrecorded  
 Surveyed in  
 Referenced out

Previous Renewals / Surveys, etc.

Corner originally set by Daniel Chaplin under contract No. 107 Dated September 21, 1864.  
 His record reads: Set post with charred stake and a mound as per instructions.

Survey on book 2, Page 299 of the Umatilla County Record of private surveys by County Surveyor Aubrey Perry calls for a stone set by John Kimbrell. No dimensions were given.

Monument and Accessories found: ( condition and source )  
 None.

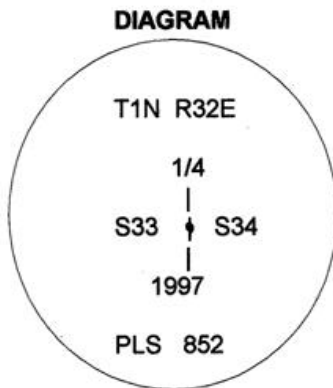

**MONUMENT (S) AND ACCESSORIES SET (Procedures and Description)**

Set a 2 1/2" brass cap on a 1 1/4" x 30" galvanized iron pipe at the proportioned point for the corner. Stamped the cap as shown in the diagram above. Set the cap 2' below the surface in a plowed field.

For references, I set four 5/8" by 24" rebars with 1.25" red plastic caps stamped ORLS 852 and WALS 13922 as described below:

- a rebar bears S58°30'W, 68.36 feet under the existing fence;
- a rebar bears S13°20'E, 35.96 feet under the existing fence;
- a rebar bears S49°21'E, 54.20 feet under the existing fence;
- a rebar bears S76°48'E, 150.68 feet under the existing fence;

Control was established using GPS receivers. The monument was set and references tied using a Geodimeter system 600, 3 second Electronic Total Station.

Location and comments

Compass Declination

Surveyors Seal

RECEIVED BY:  
Umatilla County Surveyor  
 Date: 7/30/97  
 Rec'd By: David Haddock  
 No. 97-145-16

Firm / Agency  
 Haddock Surveying  
 Address  
 P.O. Box 1574  
 Pendleton, Or. 97801  
 Party Chief  
 Stephen K, Haddock

REGISTERED  
 PROFESSIONAL  
 LAND SURVEYOR

*David L. Haddock*

OREGON  
 JULY 12, 1968  
 DAVID L. HADDOCK  
 852