

OREGON CORNER RESTORATION FORM

Section 31 Township 1N Range 32E
County Umatilla Date: June 29, 2009

Corner Designation: 1N32Z1 Condition Report Only
Not found
Remonumented
Unrecorded
Surveyed in
Referenced out

South section corner to Section 36 T1N, R31E and Section 31, T1N, R32E, W.M., Umatilla County.


Previous Renewals / Surveys, etc.

Corner originally set by David P. Thompson under contract No. 79, dated July 26, 1858. His record reads: Set post for corner to Townships 1 North, Ranges 31 and 32 East. David L. Haddock under survey 97-140-C states: Set a 1.25" x 30" galvanized iron pipe with a 2.25" brass cap with 3 iron rebars with red plastic caps for references. Also a USGS benchmark disk in a concrete cylinder which bore North 3°22'W, 8.80 feet from the corner.

Monument and Accessories found: (condition and source)

I found the brass cap and references as described by Haddock in good condition except that the USGS monument had been moved and now bears N73°30'E, 2.57 feet.

DIAGRAM

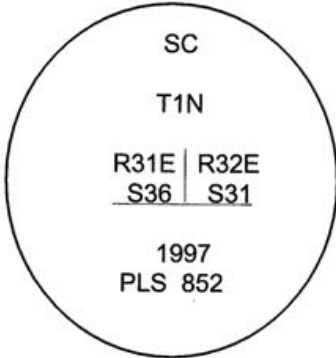

SKETCH

MONUMENT (S) AND ACCESSORIES SET (Procedures and Description)
None.

This monument was tied to report the Oregon State Plane, NAD 83/1991 coordinates only.

Measurements were made with a Trimble R7/R8 RTK GPS system.

Location and comments
NAD 83/1991 State Plane Coordinate
Oregon North Zone
N = 678,190.21 ift
E = 8,619,520.81 ift

Compass Declination

Surveyors Seal

RECEIVED BY:
Umatilla County Surveyor
Date: 6-10
Rec'd By: KK
No. 10-93-c

Firm / Agency
Witness Tree Surveying
Address
P.O. Box G
Pilot Rock, OR 97868
Party Chief
Stephen K, Haddock

REGISTERED
PROFESSIONAL
LAND SURVEYOR

Stephen K. Haddock

OREGON
JULY 9, 2001
STEPHEN K. HADDOCK
56295LS

RENEWAL DATE 6-30-11