


CERTIFIED RECORD OF LAND CORNER MONUMENTATION

South quarter corner to Section 33 , T1N, R32E, W M.

Index: 1N 32 Z-11

DIAGRAM

History of original corner establishment:
Corner originally set by Thompson in contract 79 dated 1858. His record reads: 40.00 Set a stone, 15x12x15 ins., for 1/4 sec. corner and build mound of earth as per instructions.

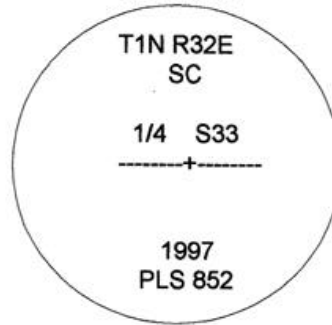

An error was discovered in the chaining along the baseline.

Thompson in contract 106, in 1864, established a new corner. His record reads: 40.00 Set stone 17x12x8 ins., for 1/4 sec. corner.

Evidence Found: Found the 1864 stone as described.

Description of monument and accessories I established to perpetuate the location of this corner:

At the position of the found stone, I set a 1.25" x 30" galvanized iron pipe with a 2.25" brass cap, stamped as shown in the diagram, 24" in the ground. I placed a mound of stone around the monument. I set a steel fence post with Umatilla County Land Survey Monument sign nearby. I set four 5/8" by 24" rebars with 1.25" red plastic caps stamped ORLS 852 and WAL5 13922 as described below:

- a rebar bears S88°44'E, 97.53 feet ;
- a rebar bears S2°19'W, 45.23 feet;
- a rebar bears N13°36'E, 49.60 feet;
- a rebar bears S84°06'W, 46.49 feet;

The bearings are true.

This work was done May 12, 1997, and witnessed by Stephen K. Haddock.

County of Umatilla

Office of _____, I hereby certify that the within instrument was filed

State of _____

in this office for record on the _____ day of _ by _____

_____(COUNTY OFFICIAL)

(DEPUTY)



David L. Haddock



RECEIVED BY

Umatilla County Surveyor

Date 7-97

Rec'd By KH

No. 97-140-C