

CERTIFIED RECORD OF LAND CORNER MONUMENTATION

South one quarter to Section 36, T1N, R32E, W M.

Index: 1N 32 Z-23


History of original corner establishment:

Corner originally set by Thompson in contract 79 dated 1858. His record reads: 40.00 Set post for 1/4 sec. corner and build a mound of earth as per instructions.

In 1864, Thompson in contract 106, Thompson established a new corner. His record reads: 40.00 Set 1/4 sec. corner in mound of earth with charred stake, pits, trench &c as per instructions. Obliterated old corner.

In 1887, under special instructions, Currin re-established this corner by setting a basalt stone, 12x8x7 ins., 8 ins. in the ground for 1/4 sec. cor. marked 1/4 SC on N. face and raised raised mound of stone 1 1/2 ft. high, 3 1/2 ft. base over it. In 1976, Scherler, Group #921, set an iron post, 28 ins. long, 2 1/2 ins. diam., 22 ins. in the ground with brass cap mkd.

DIAGRAM

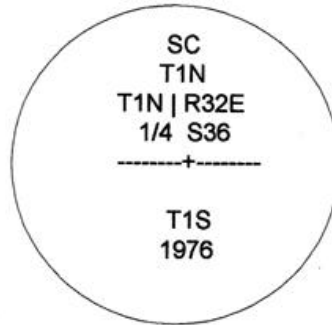

Evidence Found: Found the standard BLM brass capped monument described by Scherler. The monument was at the intersection of east - west and north fences with a collar of stone.

It is on the east side of a fence post east of a small draw. The corner of a farm access road lies NW 30 feet.

A 5/8" rebar with red plastic cap stamped RLS1333 bears S89°49"E, 119.67 feet under an east bound fence.

Description of monument and accessories I established to perpetuate the original location of this corner:

I set three 5/8" by 24" rebars with 1.25" red plastic caps stamped ORLS 852 and WAL5 13922 as described below:

a rebar bears N89°06'W, 46.96 feet under the east - west fence;

a rebar bears N0°40'W, 58.29 feet under the north bound fence;

a rebar bears N0°11'W, 109.92 feet under the north bound fence;

The bearings are true.

This work was done June 10, 1997, and witnessed by Stephen K. Haddock.

County of Umatilla

Office of \_\_\_\_\_, I hereby certify that the within instrument was filed

State of \_\_\_\_\_

in this office for record on the \_\_\_\_\_ day of \_\_\_\_\_ by \_\_\_\_\_

\_\_\_\_\_  
( COUNTY OFFICIAL ) ( DEPUTY )

REGISTERED  
PROFESSIONAL  
LAND SURVEYOR

*David L. Haddock*

OREGON  
JULY 12, 1966  
DAVID L. HADDOCK  
852

RECEIVED BY  
Umatilla County Surveyor  
Date 7-97  
Rec'd by KK  
No. 97-140-C