

OREGON CORNER RESTORATION FORM

Section 31 Township 1N Range 32E
County Umatilla Date: June 29, 2009

Corner Designation: 1N32Z5 Condition Report Only
Not found
Remonumented
Unrecorded
Surveyed in
Referenced out

South section corner to Sections 31 and 32 T1N, R32E
W.M., Umatilla County.


Previous Renewals / Surveys, etc.

Corner originally set by David P. Thompson under contract No. 79, dated July 26, 1858. His record reads: Set stone 10x10x8 ins. for corner to secs. 31 and 32, David L. Haddock, in survey 97-140-C states: Set a 1.25" x 30" galvanized iron pipe with a 2.25" brass cap at the proportionate point 4 iron rebars with red plastic caps for references.

Monument and Accessories found: (condition and source)
I found the brass cap as described by Haddock in good condition.

DIAGRAM

SKETCH

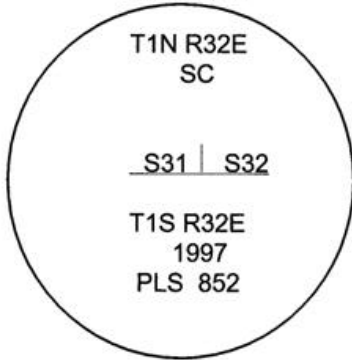

MONUMENT (S) AND ACCESSORIES SET (Procedures and Description)
None.

This monument was tied to report the Oregon State Plane, NAD 83/1991 coordinates only.

Measurements were made with a Trimble R7/R8 RTK GPS system.

Location and comments
NAD 83/1991 State Plane Coordinate
Oregon North Zone
N = 678,302.48 ift
E = 8,625,335.47 ift

Compass Declination

Surveyors Seal

REGISTERED
PROFESSIONAL
LAND SURVEYOR

Stephen K. Haddock

OREGON
JULY 9, 2001
STEPHEN K. HADDOCK
56295LS

RENEWAL DATE 6-30-11

RECEIVED BY:
Umatilla County Surveyor
Date: 6-10
Rec'd By: KK
No. 10-93-C

Firm / Agency
Witness Tree Surveying
Address
P.O. Box G
Pilot Rock, OR 97868
Party Chief
Stephen K, Haddock