

Record of Corner Monumentation

History of original corner establishment:

L-17

1/4 corner common to Section's 14 and 15, was originally set by Daniel Chaplin under contract No.107 dated Sept. 21, 1864. It was revisited by Z. F. Moody under Contract No. 145 dated April 23, 1871. Again it was revisited by Currin and Noland under special contract dated May 4, 1887. Then in the 1919 Circa C.E. Redfield again revisited the corner location and set a brass cap on a 36" pipe, stating the corner was in a wheat field.

Description of corner evidence found:

I found no trace of this corner as it falls in a field that has been farmed for many years. No doubt the monument has been destroyed during farming operations.


Description of monument and accessories I established to perpetuate the original location of this corner:

Using the monuments I recovered at the N 1/6 corner and the S 1/16 corner common to Sections 14 and 15, as was set by C.E. Redfield during his 1919 circa, I accepted these monuments as being the best available evidence to establish the true location of the 1/4 corner between Sections 14 and 15. I then used single proportionate measurements to determine the exact location of the corner of which I set a 2 1/2" aluminum cap on a 36" pipe stamped as shown in the diagram, buried to 6 inches above the surface and then placed large stones about the monument and buried all in a mound of stone.

Diagram:

T 1 N R 33 E
1/4
S 15 S 14
2002
ORLS 645

REGISTERED
PROFESSIONAL
LAND SURVEYOR

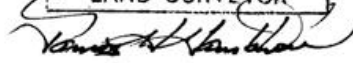

02-20-03

OREGON
JULY 10, 1984
JAMES H. HAMBLETON
645

03-35-B