

CERTIFIED RECORD OF LAND CORNER MONUMENTATION

HISTORY OF ORIGINAL CORNER ESTABLISHED:

Corner was originally established under GIO Special Contract, dated May 4, 1887, executed by James P. Currin and James E. Noland.

T 1 N R 34 E J-23

Surveyor General field notes state:

Set a basalt stone 12x10x8 in., 8 ins. in ground wkd 1/4 on N. face for 1/4 Sec. Cor,

from which:

A fir, 12 in. diam., bears S75°E, dist 13 lks. marked 1/4 SBT.

A fir 16 ins. diam. bears N85°W, dist. 45 lks. marked 1/4 SBT.

| | | |
|--|----|--|
| | S | |
| | 13 | |

Corner recovered by GIO surveyor L.E. Wilkes in resurvey of the Diminished Umatilla Indian Reservation, 1917. Field notes state:

Intersect the old 1/4 sec. cor., which is a basalt stone, 10x8x6 ins., firmly set, marked 1/4 DR on N. face, from which A fir, 20 ins. diam., bears N.74°W., 36 lks. dist., blazes healed over, not opened.

A fir, 14 ins. diam., bears S.57°E., 15 lks. dist., marked 1/4 DR BT. This tree has fallen over.

At a point 1 lk. E. of cor. Set an iron post, 3 ft. long, 2 ins. diam., 24 ins. in the ground, for witness cor. to the 1/4 sec. cor., with brass cap marked

DR
T1NR34E
S 12
WC1/4 -----
S 13
1917

from which:

A fir, 18 ins. diam., bears N. 65° E., 18 lks. dist., mkd. 1/4 S12 DR BT.
A fir, 20 ins. diam., bears S. 24° E., 39 lks. dist., mkd. 1/4 S13 DR BT.

DESCRIPTION OF CORNER EVIDENCE FOUND:

Found a 2" iron pipe with 2 1/4" brass cap, 14" above ground, from which:
A stone, 8x6 with 5" exposed, marked 1/4 on North side bears West, 0.66 ft.
A 24" fir stump bears South 74° West, a distance of 23 ft, scribe marks visible on opened blaze.

DESCRIPTION OF MONUMENT AND ACCESSORIES I ESTABLISHED TO PERPETUATE THE ORIGINAL LOCATION OF THIS CORNER:


From the brass cap monument,

NEW BEARING TREES:


- A 15" White Fir bears North 34° East, a distance of 27.00 feet, marked 1/4 S12 BT.
- A 15" White Fir bears South 32° East, a distance of 32.25 feet, marked 1/4 S13 BT.
- A 6" White Fir bears South 60° West, a distance of 13.25 feet, marked 1/4 S13 BT.
- A 12" White Fir bears North 26° West, a distance of 3.95 feet, marked 1/4 S12 BT.

I hereby certify that the corner was perpetuated on September 25, 2018.

Witness: Kyle Tucker

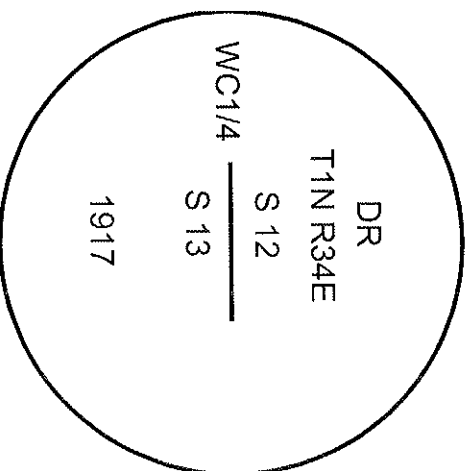

I used a steel tape and magnetic compass in the establishment of the new accessories. I used 13° East declination, the distances are to a 60d spike driven into the side of the root crown of the bearing trees. A brass washer marked OPIS 83571 is attached to the BT blaze of the new bearing trees.

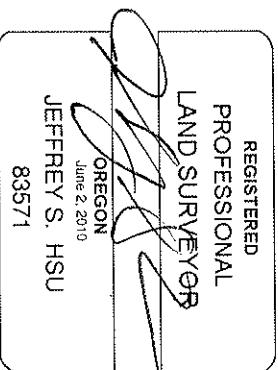

Renewal Date: June 30, 2019

RECEIVED BY

Umatilla County Surveyor

J-23

Date: 10/23/2018

Flood By: TMA

No.: 18-094-R