

CERTIFIED RECORD OF LAND CORNER MONUMENTATION

HISTORY OF ORIGINAL CORNER ESTABLISHED:


Corner monumented by James Currin and James Noland under special GLO contract dated May 4, 1887. Surveyor General field notes state:

Set basalt stone 12x10x6 in, 18 ins. in the ground marked 3 notches on S, 3 notches on E edges for Cor to Secs 15, 16, 21 and 22. Raised a mound of stone over it.

Corner found and monumented by Dave Krumbein in Survey Number I-017-C. Survey states:

Found stone mound. Set Brass Cap.

T 1 N R 34 E N-13

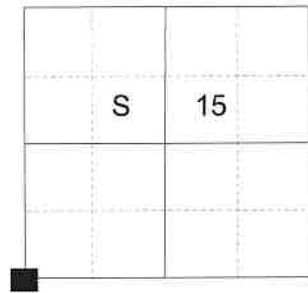

DESCRIPTION OF CORNER EVIDENCE FOUND:

None. Area has shown signs of past logging activity.

SEE SURVEY FOR CTUIR DATED MAY 2019

DESCRIPTION OF MONUMENT AND ACCESSORIES I ESTABLISHED TO PERPETUATE THE ORIGINAL LOCATION OF THIS CORNER:

At position determined by survey, I set a 2 1/2" x 30" aluminum pipe with 3" aluminum cap marked as shown below, 24 inches in the ground in a collar of stone 3 ft. diam., from which:

NEW BEARING OBJECTS:

- A 7" Douglas Fir bears North 63° East, a distance of 18.35 feet, marked T1NR34ES15 BT.
- A 5" Ponderosa Pine bears South 23° East, a distance of 26.95 feet, marked T1NR34ES22 BT.
- A 9" Douglas Fir bears South 87° West, a distance of 14.85 feet, marked T1NR34ES21 BT.
- A 10" Douglas Fir bears North 26° West, a distance of 6.75 feet, marked T1NR34ES16 BT.


Set a steel fencepost 1 ft. North of corner monument.

I hereby certify that the corner was perpetuated on May 14, 2019.

Witness: Kyle A. Tucker



Renewal Date: June 30, 2019

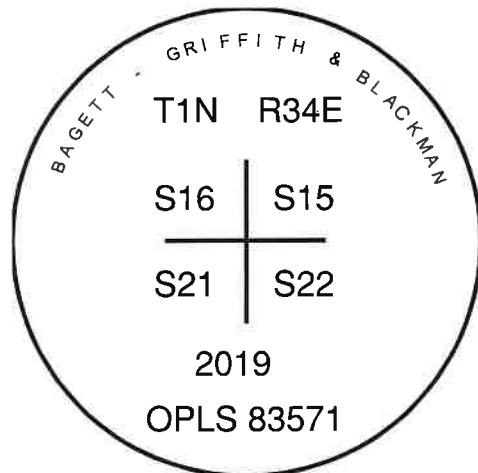

I use a steel tape and magnetic compass in the establishment of the accessories. Magnetic declination used was 13°. Bearings are to a washer in the BT Blaze marked OPLS 83571. Distances are to a 60d spike in the root crown of the tree.