

CERTIFIED RECORD OF LAND CORNER MONUMENTATION

**HISTORY OF ORIGINAL CORNER ESTABLISHED:**

Corner originally established under GIO Special Contract dated May 4, 1887, executed by James P. Currin and James E. Noland. Surveyor General field notes state:

Set basalt stone 16x12x10 in., 11 ins. in the ground marked 1/4 on N. face for 1/4 Sec. Cor. Raised a mound of stone over it. Pits impracticable.

T 1 N R 34 E N-19

	S	
	23	

**DESCRIPTION OF CORNER EVIDENCE FOUND:**

A prominent fence corner with K-tag attached, from which fences bear North, South and West. Long time resident and current landowner to the West attested that the fence heading to the West was originally in the same spot it exists today for as long as he can remember, approximately 80 years. Due to harmony with the nearest found corners, I accept this fence corner as the best available evidence of the original corner position.

**DESCRIPTION OF MONUMENT AND ACCESSORIES I ESTABLISHED TO PERPETUATE THE ORIGINAL LOCATION OF THIS CORNER:**


Along the South side of the fence corner, I set a 2 1/2" x 30" aluminum pipe, 22 in. in the ground, with a 2 1/2" aluminum cap, marked as shown below, from which:

**NEW BEARING OBJECTS:**


- A 5/8" iron pin bears North 2°24' West, a distance of 14.87 feet, with 1 1/2" aluminum cap marked BGB SURVEY MARKER N RP.
- A 5/8" iron pin bears North 85°27' East, a distance of 33.58 feet, with 1 1/2" aluminum cap marked BGB SURVEY MARKER E RP.
- A 5/8" iron pin bears South 1°40' West, a distance of 27.87 feet, with 1 1/2" aluminum cap marked BGB SURVEY MARKER S RP.
- A 5/8" iron pin bears North 89°56' West, a distance of 25.90 feet, with 1 1/2" aluminum cap marked BGB SURVEY MARKER W RP.

I certify this corner was monumented September 13, 2018.

Witness: Ryan Skeen

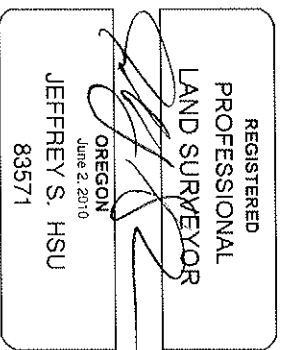

Renewal Date: June 30, 2019

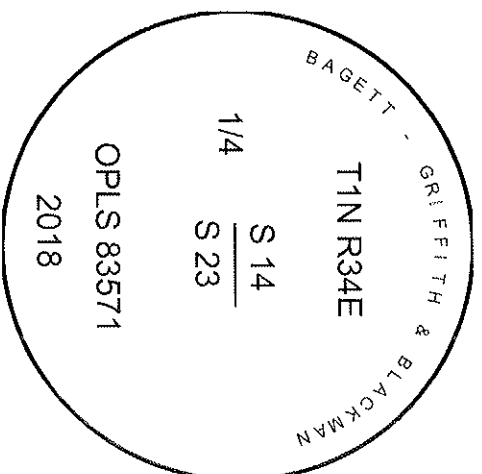

**RECEIVED BY**

Umatilla County Surveyor

Date: 10/23/2018

Rec'd By: TMA

No.: 18-094-R

I used a RTK GPS in the establishment of the new accessories. Basis of bearing is as per survey for Hancock Forest Management dated Oct. 2018. Bearings and distances to the center of the aluminum caps.