

CERTIFIED RECORD OF LAND CORNER MONUMENTATION

HISTORY OF ORIGINAL CORNER ESTABLISHED:

Corner originally established under GIO Special Contract dated May 4, 1887, executed by James P. Currin and James E. Noland. Surveyor General field notes state:

T 1 N R 34 E N-21

Set stone 18x12x6 in., 14 ins. in the ground, for cor to Secs. 13, 14, 23 and 24 marked with 3 notches on S and 1 notch on E. edges and raised a mound of stone over it. Pits impracticable.

	S	23

DESCRIPTION OF CORNER EVIDENCE FOUND:


None.

DESCRIPTION OF MONUMENT AND ACCESSORIES I ESTABLISHED TO PERPETUATE THE ORIGINAL LOCATION OF THIS CORNER:

At proportionate position, I set a 5/8" x 15" iron pin, 12 in. in the ground, drilled into bedrock, with a 2 3/4" aluminum cap, marked as shown below, from which:


NEW BEARING OBJECTS:

- A 4'X4' rock outcrop bears North 69°55' East, a distance of 49.65 feet, marked X BO.
- A 5'x5' rock outcrop bears South 49°47' East, a distance of 55.45 feet, marked X BO.
- A 5/8" iron pin bears South 47°17' West, a distance of 16.90 feet, marked BGB SURVEY MARKER SW RP.
- A 5/8" iron pin bears North 40°22' West, a distance of 14.45 feet, marked BGB SURVEY MARKER NW RP.

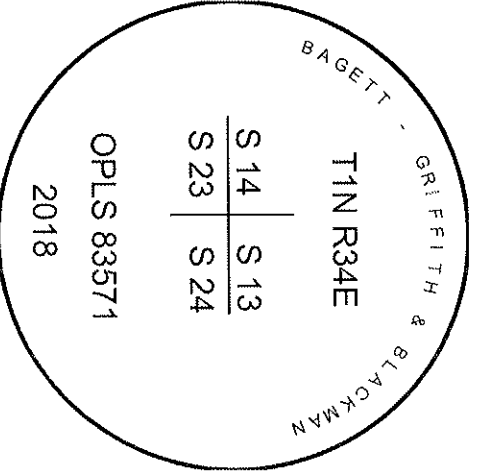

I certify this corner was monumented October 10, 2018.

Witness: Kyle Tucker, Renee Naumann

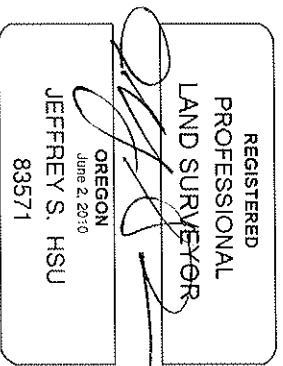

Renewal Date: June 30, 2019

I used a RTK GPS in the establishment of the new accessories. Basis of bearing is as per survey for Hancock Forest Management dated Oct. 2018. Bearings and distances to rock outcrops are the to center of the 'X'. Bearings and distances to the aluminum caps are to the center.

RECEIVED BY

Umatilla County Surveyor

N-21

Date: 10/23/2018

Rec'd By: JMA

No.: 18-094-R