

CERTIFIED RECORD OF LAND CORNER MONUMENTATION

**HISTORY OF ORIGINAL CORNER ESTABLISHED:**

Corner not previously established.

T 1 N R 34 E Q-23

S	24

**DESCRIPTION OF CORNER EVIDENCE FOUND:**

None.

**DESCRIPTION OF MONUMENT AND ACCESSORIES I ESTABLISHED TO PERPETUATE THE ORIGINAL LOCATION OF THIS CORNER:**


At position determined by survey, I set a 5/8" x 30" iron pin, 30 in. in the ground, with a 2 1/4" aluminum cap, marked as shown below, in a collar of stone 3 ft. diam., from which:

**NEW BEARING TREES:**


A 6" White Fir bears South 88° West, a distance of 28.05 feet, marked CS 1/16 S24 BT.  
An 8" Douglas Fir bears North 13° West, a distance of 6.90 feet, marked CS 1/16 S24 BT.

Set a steel fencepost approx. 2 ft. South of corner. I certify this corner was monumented October 12, 2018.

Witness: Kyle Tucker

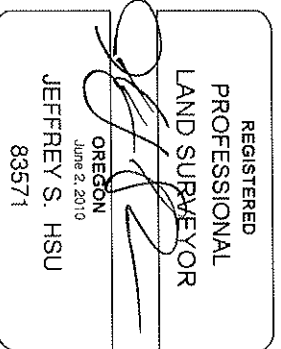

Renewal Date: June 30, 2019

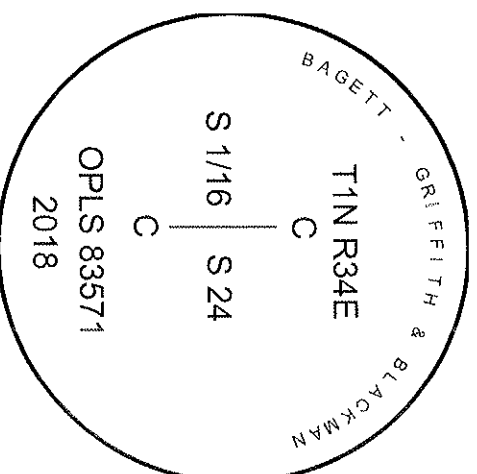

**RECEIVED BY**

Umatilla County Surveyor  
Date: 10/23/2018  
Received By: TMA  
No.: 18-099-R

I used a steel tape and magnetic compass in the establishment of the new accessories. I used 13° East declination, the distances are to a 60d spike driven into the side of the root crown of the bearing trees. A brass washer marked OPLS 83571 is attached to the BT blaze of the new bearing trees.