


**CERTIFIED RECORD OF LAND CORNER MONUMENTATION**

**HISTORY OF ORIGINAL CORNER ESTABLISHMENT:**

Corner originally established by Currin and Noland under GLO special contract dated May 4, 1887. Surveyor General record states:

Set a basalt stone 18x16x12 in, 14 ins. in the ground, marked 1/4 S on N side for 1/4 sec. cor, from which:  
A fir 5 in. dia. bears S5°W, 42 lks. distant marked 1/4 S BT.  
A Pine 30 in. dia. bears N80°W, 109 lks. distant marked 1/4 S BT.

T 1 N R 34 E R-23

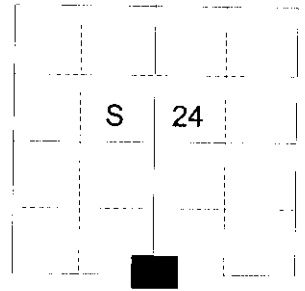

**DESCRIPTION OF CORNER EVIDENCE FOUND:**

None.

**DESCRIPTION OF MONUMENT AND ACCESSORIES I ESTABLISHED**

**TO PERPETUATE THE ORIGINAL LOCATION OF THIS CORNER:**

At proportionate position, I set a 2 1/2" x 30" aluminum pipe with 2 1/2" aluminum cap, marked as shown below, 7 inches in the ground, in a mound of stone 3 ft. diam., from which:


- An 11 in. Ponderosa Pine bears North 40° East, a distance of 139.15 feet, marked 1/4 S24 BT.
- A 10 inch Ponderosa Pine bears South 31° East, a distance of 57.65 feet, marked 1/4 S25 BT.
- A 13 inch Douglas Fir bears South 16° West, a distance of 28.75 feet, marked 1/4 S25 BT.
- An 8 inch Douglas Fir bears North 53° West, a distance of 55.95 feet, marked 1/4 S25 BT.

I hereby certify that the corner was monumented on September 10, 2013.

REGISTERED  
PROFESSIONAL  
LAND SURVEYOR

*Jeffrey S. Hsu*  
OREGON  
June 2, 2010  
JEFFREY S. HSU  
83571

Renewal Date: June 30, 2015

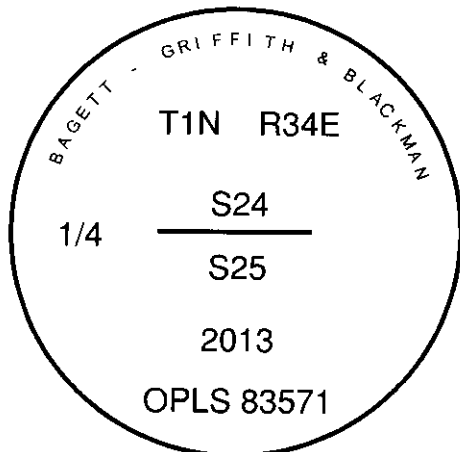

I used magnetic compass and steel tape in the establishment of the bearing trees. Magnetic Declination used was 16° East. Distances are to a 60d spike in the right hand side of the root crown of the trees. Bearings are to a brass washer marked OPLS 83571 in the lower BT blaze of the new bearing trees.

**RECEIVED BY**  
Umatilla County Surveyor  
Date: 9/20/2013  
Rec'd By: [Signature]  
No.: 13-521-B