


CERTIFIED RECORD OF LAND CORNER MONUMENTATION

HISTORY OF ORIGINAL CORNER ESTABLISHMENT:

Corner originally established by Currin and Noland under GLO special contract dated May 4, 1887. Surveyor General record states:
Set basalt stone 18x10x8 ins. 12 ins. in the ground for cor to Secs. 19, 24, 25 and 30, marked 2 notches on S. and 4 on N. edges, from which:
A Pine 16 ins. in diam bs. N52°E, dist 175 lks., marked T1N R35E S19 BT.
A Fir 10 ins. in diam.bs S80°E, dist 52 lks. mkd. S30 BT.
A Fir 12 ins. in diam. bs. S35°W. dist 20 lks mkd S25 BT.
A pine 18 ins. in diam bs. N50°W. dist 143 lks. mkd R34E S24 BT.

T 1 N R 35 E R-01

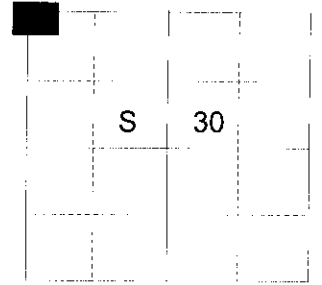

In 1975, corner brought to county standard by Chris Palmer in survey filed as 03-274-C. No monumentation record could be found.

DESCRIPTION OF CORNER EVIDENCE FOUND:

Found 1 1/2" iron pipe with 2" brass cap, marked as shown below, 16 inches above ground, in a collar of stone 2 ft. diam., from which:

A 15 inch Douglas Fir bears South 31° West, a distance of 33.45 feet, alive and vigorous with a healed blaze and bearing tree tag.

A 13 inch Ponderosa Pine bears North 64° West, a distance of 36.40 feet, alive and vigorous with scribe marks visible on an partially healed blaze.

DESCRIPTION OF MONUMENT AND ACCESSORIES I ESTABLISHED

TO PERPETUATE THE ORIGINAL LOCATION OF THIS CORNER:

From the iron pipe monument, I take a new bearing tree.

A 13 inch Ponderosa Pine bears North 18° East, a distance of 10.70 feet, marked T1N R35E S19 BT.


A 15 inch Ponderosa Pine bears South, a distance of 28.80 feet, marked T1N R35E S30 BT.

Corner falls approximately 7 feet East of a North/South running fence and approximately 13 feet West of the centerline of a North/South running gravel road.

I hereby certify that the corner was perpetuated on August 19, 2013.



Renewal Date: June 30, 2015

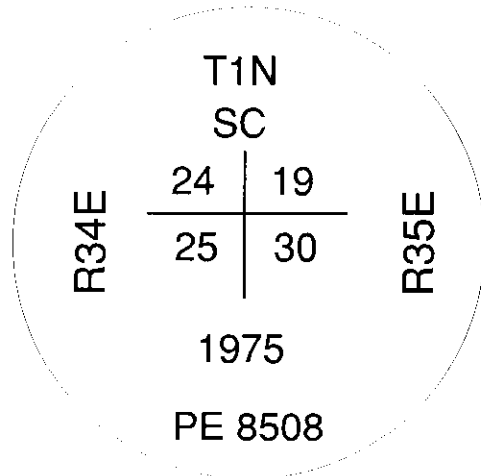

I used a steel tape and magnetic compass in the recovery of the bearing trees and establishment of new trees. I used 16° East magnetic declination and the bearings and distances are to the center of root crown on old bearing trees. Distance is to a 60d spike in the right hand side of the new trees. Bearing is to a brass washer marked OPLS 83571 in the lower BT blaze.

RECEIVED BY

Umatilla County Surveyor

Date: 9/20/2013

Rec'd By: Day John

No.: 13-521-B