

CERTIFIED RECORD OF LAND CORNER MONUMENTATION

HISTORY OF ORIGINAL CORNER ESTABLISHED:


Corner originally established under GLO Special Instructions dated May 4, 1887 executed by N. Currin and E. Noland. Surveyor General record states:

Set post 3 ft long, 3 ins square 24 ins in the ground for 1/4 sec cor marked 1/4 S on N face from which:
A fir 14 ins. diam. bears N 70° E 17 lks dist marked 1/4 S BT.
A fir 16 ins. diam. bears S 45° E 28 lks dist marked 1/4 S BT.

Corner was remonumented from original accessories by L. E. Wilkes in Dependent Resurvey completed under GLO Contract No. 29, dated May 3, 1917. Surveyor General record states:

Intersect the point for 1/4 sec. cor., located by reference to the bearing trees. At the exact cor. point
Set an iron post, 3 ft. long, 2 ins. diam., 24 ins. in the ground, for 1/4 sec. cor., with brass cap marked as shown.
From which:
A fir, 18 ins. diam., bears S 45° E, 28 lks. dist., blazes healed over, not opened (Old B.T.)
A fir, 24 ins. diam., bears N 70° E, 36 lks. dist., blazes healed over, not opened (Old B.T.)

T 1 N R 35 E J-03

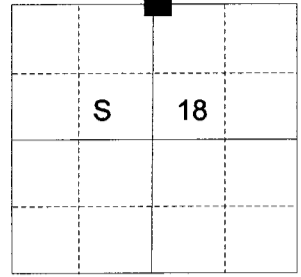

DESCRIPTION OF CORNER EVIDENCE FOUND:

Found a 1 3/4" iron pipe with a 2 1/2" brass cap marked as shown below, 8" above ground.
Found a 15" stump bears North 70° East, a distance of 23.5 feet, with healed blaze evident.
Found a 15 inch dead and downed tree, the stump hole which bears South 45° East, a distance of 19 feet.

DESCRIPTION OF MONUMENT AND ACCESSORIES I ESTABLISHED TO PERPETUATE THE ORIGINAL LOCATION OF THIS CORNER:

From the Iron Pipe monument,

NEW BEARING OBJECTS:

A 16 inch Douglas Fir bears North 20° East, a distance of 50.70 feet, marked 1/4 S7 BT.
A 17 inch Douglas Fir bears North 79° West, a distance of 62.50 feet, marked X BT.
A 15 inch Douglas Fir bears South 5° West, a distance of 37.00 feet, marked 1/4 S18 BT
A 16 inch Douglas Fir bears North 5° West, a distance of 37.70 feet, marked 1/4 S7 BT.


Set a steel fencepost approximately 1 foot East of corner monument.

I hereby certify that the corner was perpetuated on October 6, 2014.

Witness: Thomas J. Kopp



Renewal Date: June 30, 2015

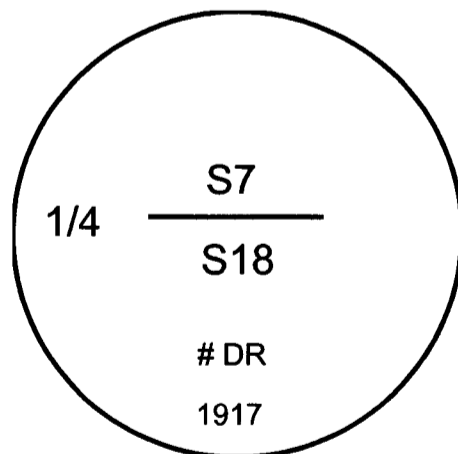

I used a steel tape and magnetic compass in the establishment of the new accessories. I used 16° East declination, the distances are to a 60d spike driven into the right side of the root crown of the new bearing trees. A brass washer marked OPLS 83571 is attached to the BT blaze of the new bearing trees.