

CERTIFIED RECORD OF LAND CORNER MONUMENTATION

HISTORY OF ORIGINAL CORNER ESTABLISHED:


Corner originally established under GLO Special Instructions dated May 4, 1887 executed by N. Currin and E. Noland. Surveyor General record states:

Set basalt stone 9x8x7 ins. 6 ins. in the ground for cor. to secs. 7, 8, 17 and 18, marked with 4 notches on S. and 5 notches on E. edges and raised mound of stone over it.

Corner was found and remonumented by L. E. Wilkes in Dependent Resurvey completed under GLO Contract No. 29, dated May 3, 1917. Surveyor General record states:

Intersect a small mound of stone, which I accept as the point for cor. of secs. 7, 8, 17 and 18. At the center of the mound of stone, set an iron post, 3 ft. long, 2 ins. diam., 14 ins. in the ground to bedrock, surrounded by a substantial mound of stone, for cor. of secs. 7, 8, 17 and 18 with brass cap, from which:
A pine, 48 ins. diam., bears S.45°45'E., 155 lks. dist., marked T1N R35E S17 DR BT.
A pine, 48 ins. diam., bears S.12°30'W., 228 lks. dist., marked T1N R35E S18 DR BT.
No other trees available; raise a mound of stone, 3 ft. base, 2 ft. high, W. of cor.

T 1 N R 35 E J-05

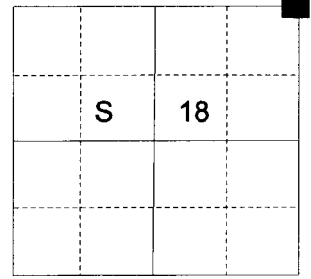

Corner recovered by Chris Palmer in Survey Number 03-274-C (also filed as M-045-C), Steven Haddock in Survey Number 08-145-B, and William Wells in Survey Number 10-131-B.

DESCRIPTION OF CORNER EVIDENCE FOUND:

Found a 1 3/4" iron pipe with a 2 1/2" brass cap marked as shown below, 14" above ground in a mound of stone, 2 ft. diam, from which:

A 49 inch Ponderosa Pine bears South 41° East, a distance of 101.30 feet, alive and vigorous with healed blaze.
A 47 inch Ponderosa Pine bears South 17° West, a distance of 149.50 feet, alive and vigorous with healed blaze.

DESCRIPTION OF MONUMENT AND ACCESSORIES I ESTABLISHED TO PERPETUATE THE ORIGINAL LOCATION OF THIS CORNER:

From the Iron Pipe monument,

NEW BEARING OBJECTS:


A 5/8" iron rebar bears North 0°09' East, a distance of 19.02 feet, with 1 1/2" aluminum cap marked BGB SURVEY MARKER N RP.
A 5/8" iron rebar bears South 86°16' East, a distance of 20.02 feet, with 1 1/2" aluminum cap marked BGB SURVEY MARKER E RP.

I hereby certify that the corner was perpetuated on October 6, 2014.

Witness: Thomas J. Kopp



Renewal Date: June 30, 2015

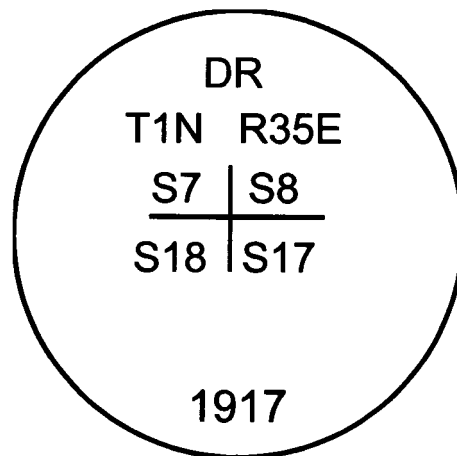

I used a steel tape and magnetic compass in the recovery of the old bearing trees. I used 16° East declination, the distances are to the center of the trees. I use a Leica GS15 RTK GPS in the establishment of the new accessories. Basis of bearing is a per survey for Hancock Forest Management, dated October 2014.