


CERTIFIED RECORD OF LAND CORNER MONUMENTATION

HISTORY OF ORIGINAL CORNER ESTABLISHED:

Corner not previously established.

T 1 N R 35 E L-02

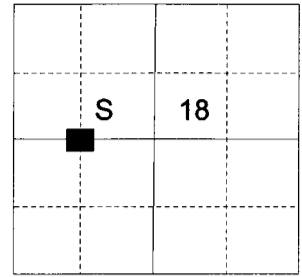

DESCRIPTION OF CORNER EVIDENCE FOUND:

None.

DESCRIPTION OF MONUMENT AND ACCESSORIES I ESTABLISHED

TO PERPETUATE THE ORIGINAL LOCATION OF THIS CORNER:

At position determined by survey, I set a 5/8" x 30" iron rebar, 27 inches in the ground, with a 2 1/2" aluminum cap, marked as shown below, in a collar of stone, 1 1/2 ft. diam., from which:

A 19 inch Ponderosa Pine bears North 65° East, a distance of 63.35 feet, marked CW 1/16 S18 BT.


A 9 inch Ponderosa Pine bears South 33° West, a distance of 131.24 feet, marked CW 1/16 S18 BT.

Set a steel fencepost approximately 1 foot North of corner monument.

I hereby certify that the corner was monumented on October 9, 2014.



Renewal Date: June 30, 2015

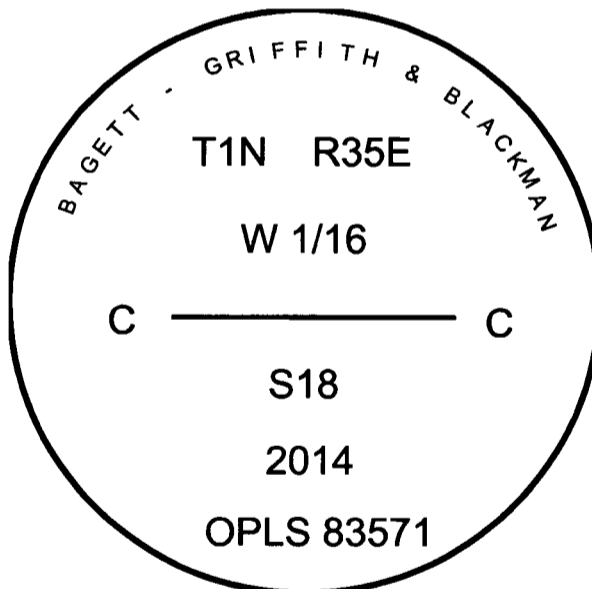

I used a steel tape and magnetic compass in the establishment of the new bearing trees. I used 16° East declination, the distances are to a 60d spike in the right hand side of the root crown.

14-137-B