

CERTIFIED RECORD OF LAND CORNER MONUMENTATION


HISTORY OF ORIGINAL CORNER ESTABLISHED:

Corner originally established under GLO Special Instructions dated May 4, 1887 executed by N. Currin and E. Noland. Surveyor General record states:

Set post 3 ft. long, 3 ins. square, 24 ins. in the ground for 1/4 Sec. Cor, from which:
A tamarack 14 ins. diam., bears N85°W, 28 lks. dist. marked 1/4 S BT.
A fir, 16 ins. diam., bears S45°E, 30 lks. dist., marked 1/4 S BT.

Corner searched for and not found by by Chris Palmer in Survey Number 03-274-C (also filed as M-045-C), Steven Haddock in Survey Number 08-145-B, and William Wells in Survey Number 10-131-B.

T 1 N R 35 E L-05

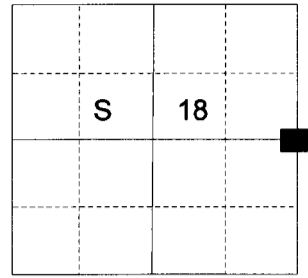

DESCRIPTION OF CORNER EVIDENCE FOUND:

None.

DESCRIPTION OF MONUMENT AND ACCESSORIES I ESTABLISHED

TO PERPETUATE THE ORIGINAL LOCATION OF THIS CORNER:

At proportionate position, I set a 2 1/2" aluminum pipe with 2 1/2" aluminum cap, marked as shown below, 26 inches in the ground, in a collar of stone 1 ft. in diam., from which:


- A 5 inch White Fir bears North 22° East, a distance of 28.65 feet, marked 1/4 S17 BT.
- A 5/8" iron rebar bears South 26°11' East, a distance of 27.62 feet, marked BGB SURVEY MARKER SE RP.
- A 5/8" iron rebar bears South 62°02' West, a distance of 32.58 feet, marked BGB SURVEY MARKER SW RP.
- A 6 inch White Fir bears North 57° West, a distance of 91.75 feet, marked 1/4 S18 BT.

Set a steel fencepost approximately 1 foot North of corner monument.

I hereby certify that the corner was perpetuated on October 8, 2014.



Renewal Date: June 30, 2015

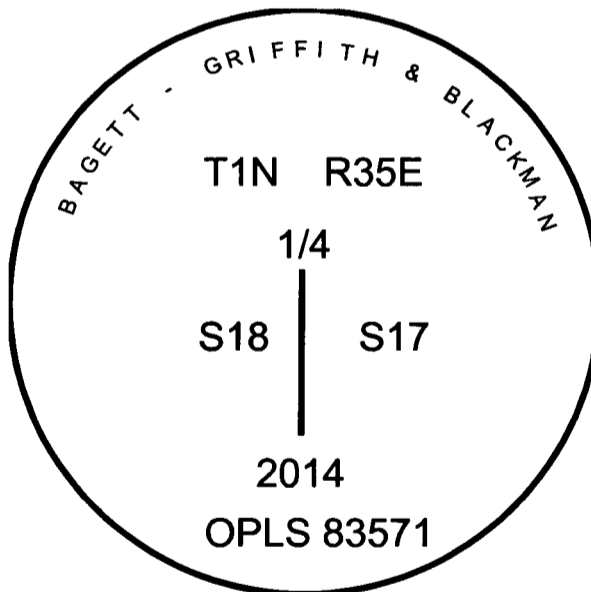

I used a steel tape and magnetic compass in the establishment of the new bearing trees. I used 16° East declination, the distances are to a 60d spike in the right hand side of the root crown. I use a Leica GS15 RTK GPS in the establishment of the new rebar accessories. Basis of bearing is a per survey for Hancock Forest Management, dated October 2014.

14-137-B