

CERTIFIED RECORD OF LAND CORNER MONUMENTATION


HISTORY OF ORIGINAL CORNER ESTABLISHED:

Corner originally established under GLO Special Instructions dated May 4, 1887 executed by N. Currin and E. Noland. Surveyor General record states:

Set a basalt stone 10x10x8 ins., 7 ins. in the ground for Cor. to Secs. 13, 18, 19 and 24, from which:
A pine, 10 ins. in diam. bs. N50°E, dist. 217 lks. mkd T1N R35E S18 BT.
A pine, 6 ins. in diam. bs. S80°E, dist 300 lks. mkd S19 BT.
Raised mound of stone alongside.

Corner was positioned by BT's by Chris Palmer is survey M-045-C (also filed as 03-274-C). No monument was set.

T 1 N R 35 E N-01

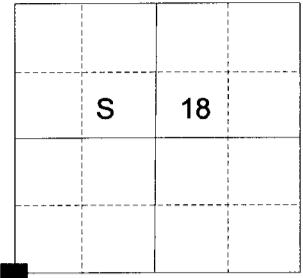

DESCRIPTION OF CORNER EVIDENCE FOUND:

Found a prominent 4 ft. diameter mound of stone. No marked stone or bearing trees found.

DESCRIPTION OF MONUMENT AND ACCESSORIES I ESTABLISHED TO PERPETUATE THE ORIGINAL LOCATION OF THIS CORNER:

At the mound position, I set a 2 1/2" x 30" aluminum pipe with 2 1/2" aluminum cap, marked as shown below, 7 inches in the ground, in a mound of stone 4 ft. diam., from which:


- An 8 inch Ponderosa Pine bears North 32° East, a distance of 83.00 feet, marked T1N R35E S18 BT.
- A 10 inch Ponderosa Pine bears South 31° East, a distance of 44.10 feet, marked T1N R35E S19 BT.
- A 10 inch Ponderosa Pine bears South 9° West, a distance of 41.20 feet, marked T1N R35E S24 BT.
- A 7 inch Ponderosa Pine bears North 2° West, a distance of 108.30 feet, marked T1N R35E S13 BT.

Set a steel fencepost approximately 3 feet North of corner monument.

I hereby certify that the corner was monumented on October 8, 2014.



Renewal Date: June 30, 2015

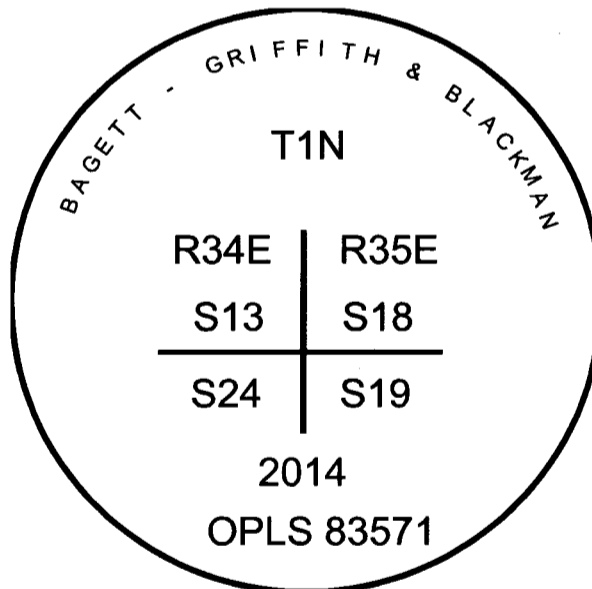

I used a steel tape and magnetic compass in the establishment of the new bearing trees. I used 16° East declination, the distances are to a 60d spike in the right hand side of the root crown.

14-137-B