


CERTIFIED RECORD OF LAND CORNER MONUMENTATION

HISTORY OF ORIGINAL CORNER ESTABLISHED:

Corner not previously established.

T 1 N R 35 E O-04

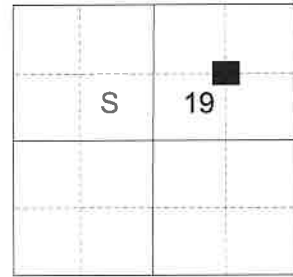

DESCRIPTION OF CORNER EVIDENCE FOUND:

None.

DESCRIPTION OF MONUMENT AND ACCESSORIES I ESTABLISHED TO MONUMENT THE ORIGINAL LOCATION OF THIS CORNER:

At position by Survey I set a 5/8" x 22" iron pin, drilled 18" into rock, with 2 1/2" aluminum cap marked as shown below, in a 2' diam. collar of stone, from which:

NEW BEARING OBJECTS:

A 9" Ponderosa Pine bears North 37° East a dist. of 37.65 ft., marked NE 1/16 S19 BT.
A double bole Ponderosa Pine, both boles being 8" diam., bears South 8° East a dist. of 76.35 ft., marked NE 1/16 S19 BT on most easterly bole.


Set steel fence post approx. 0.3 ft. North

Falls approx. 20 ft. North of Northeasterly running forest road.

I hereby certify that the corner was monumented on October 10, 2019.
Witness: Kyle A. Tucker



Renewal Date: June 30, 2021

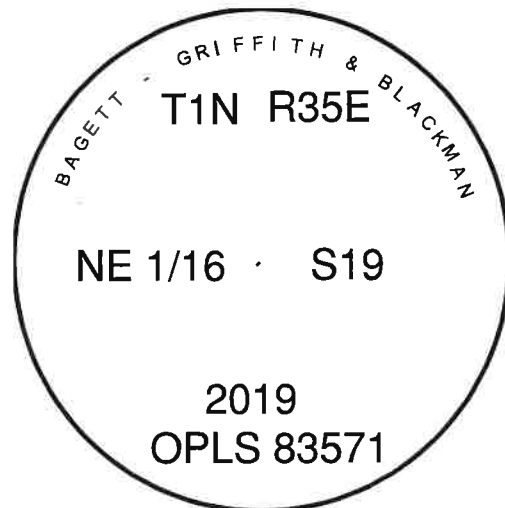

I used a steel tape and magnetic compass in the establishment of the new accessories. I used 13° East declination, the distances are to a 60d spike driven into the right side of the root crown of the bearing trees. A brass washer marked OPLS 83571 is attached to the BT blaze of the new bearing trees.