


CERTIFIED RECORD OF LAND CORNER MONUMENTATION

HISTORY OF ORIGINAL CORNER ESTABLISHED:

Corner originally established under GLO special contract, executed by Currin and Noland, dated May 4, 1887. Surveyor General field notes state: Set post 3 ft. long, 3 ins. square, 24" in the ground, for 1/4 sec. cor. mkd. 1/4S on W. face from which:
A fir 10 ins. diam. bears N60°E 43 lks dist. mkd. 1/4 SBT
A fir 10 ins. diam. bears N30°W 80 lks dist. mkd. 1/4 SBT

T 1 N R 35 E P-17

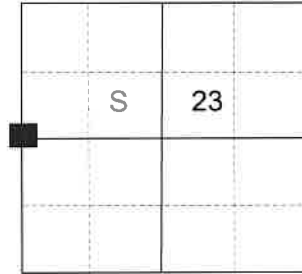

DESCRIPTION OF CORNER EVIDENCE FOUND:

None found. Area has been logged extensively

DESCRIPTION OF MONUMENT AND ACCESSORIES I ESTABLISHED TO PERPETUATE THE ORIGINAL LOCATION OF THIS CORNER:

At position by Survey I set a 2 1/2" x 30" aluminum pipe, 29" in the ground, with 3" aluminum cap marked as shown below, from which:

NEW BEARING OBJECTS:


- A 4" White Fir bears North 73° East, a dist. of 6.50 ft., marked 1/4 S23 BT.
- A 4" White Fir bears South 40° East, a dist. of 5.70 ft., marked X BT.
- A 3" White Fir bears South 45° West, a dist. of 3.15 ft., marked X BT.
- A 4" Douglas Fir bears North 45° West, a dist. of 8.20 ft., marked X BT.

Set steel fence post approx. 1 ft. North

I hereby certify that the corner was monumented on September 22, 2021.
Witness: Kyle A. Tucker, Emmitt Ambert



Renewal Date: June 30, 2023

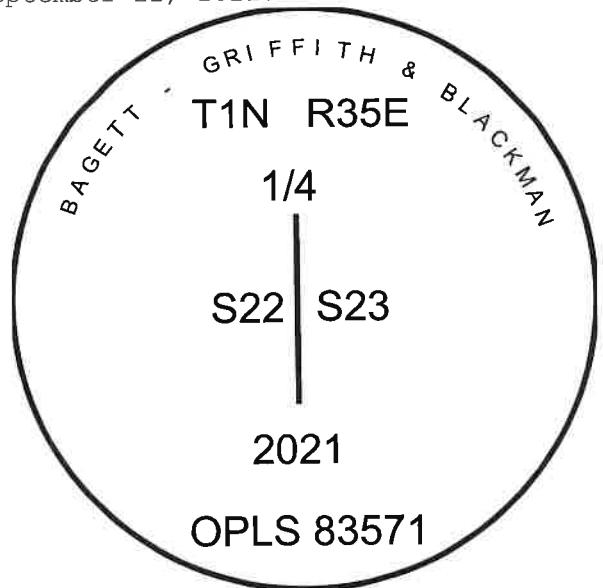

I used a steel tape and magnetic compass in the establishment of the new accessories. I used 14° East declination. Distances are to a 60d spike driven into the right side of the root crown of the bearing trees. Bearings are to a brass washer marked OPLS 83571 in the BT blaze of the new bearing trees.