


**CERTIFIED RECORD OF LAND CORNER MONUMENTATION**

**HISTORY OF ORIGINAL CORNER ESTABLISHMENT:**  
Corner not previously established

T 1 N R 35 E P-02

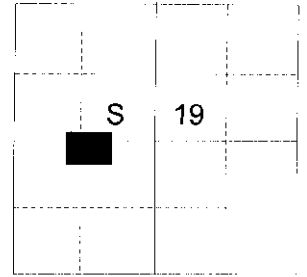

**DESCRIPTION OF CORNER EVIDENCE FOUND:**  
None.

**DESCRIPTION OF MONUMENT AND ACCESSORIES I ESTABLISHED  
TO PERPETUATE THE ORIGINAL LOCATION OF THIS CORNER:**

At position established by survey, I set a 5/8" x 30" iron rebar with a 2 1/2" aluminum cap marked as shown below, 28 inches in the ground, in a collar of stone 1 1/2 ft. diam., from which:


- A 13 inch Ponderoas Pine bears South 66° East, a distance of 44.20 feet, marked CW 1/16 S19 BT.
- A 7 inch Ponderosa Pine bears North 44° West, a distance of 40.65 feet, marked X BT.

I set a steel fencepost approximately 1 ft. North of corner monument.

I hereby certify that the corner was monumented on September 9, 2013.



Renewal Date: June 30, 2015

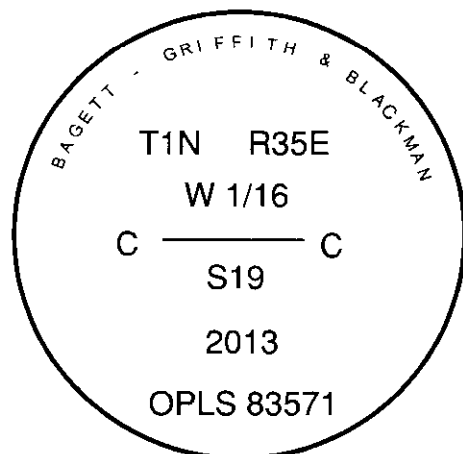

I used a steel tape and magnetic compass in the establishment of the bearing trees. Magnetic declination used was 16° East. Bearings are to a washer marked OPLS 83571 in the lower BT blaze. Distances are to a 60d spike in the side of the root crown of the bearing trees.

**RECEIVED BY**  
Umatilla County Surveyor  
Date: 9/20/2013  
Rec'd By: Day Tolat  
No.: 13-521-B